

MISSISSIPPI DEPARTMENT OF NATURAL RESOURCES

Bureau of Land and Water Resources

Southport Mall

P.O. Box 10631

CODED

Jackson, Mississippi 39209

WATER WELL DRILLERS LOG

Wayne  
Z 71  
5/24/84

May 24 1984 date/well completed  
Porter Drilling & Log firm name  
Wayne county well located

LANDOWNER: Evelyn Douglas  
201 State Line, Miss.

description of formations encountered	from	to
clay	0	12
sand	12	24
clay & sand	24	28
clay	28	90
sand	90	99
clay	99	118
sand	118	128
clay	128	135
sand & clay	135	155
clay	155	178
sand	178	186
clay	186	195
sand & clay	195	212
clay some hard sand	212	264
sand with clay	264	285
clay	285	330
fine clean sand	330	345
fine sand clean sand	345	360

(mailing address)

WELL LOCATION:  
sec 26 T 60 N R 5 E  
6 miles S of Buchatun (distance) (direction) (nearest town)

WELL PURPOSE: home  
(home, irrigation, municipal, industrial)

WELL COMPLETION DATA:

- (1) diameter (inches) 2"
- (2) total depth (feet) 360
- (3) static water level (feet) 10' below top of ground. (above)
- (4) casing PVC 350' (material) (depth)
- 2" (size) if telescope see back.
- (5) screen 10' 350' (length) (depth to top)
- 2" hole S.S. (size) (material)
- (6) pump none 14 flow (HP) (yield gpm)
- (type power)
- (7) electric log no (yes or no)
- (organization running log)
- (8) how well bottom plugged 2" sand above

CODED

DEPT. OF NATURAL RESOURCES  
BUREAU OF LAND & WATER RESOURCES


AUG 6 1984

DRILLERS REMARKS:

RECEIVED

If well telescopes please  
sketch and show depths.

GROUND LEVEL

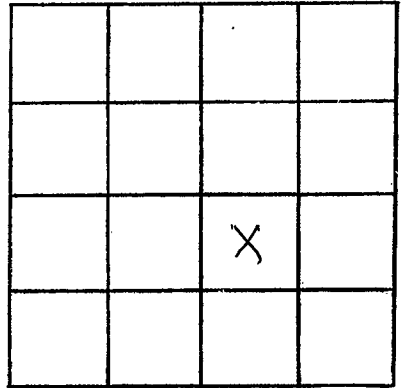

SECTION 26

Please indicate well location X.

ADDITIONAL INFORMATION

If more than one screen,  
show locations of each on sketch.