

MISSISSIPPI DEPARTMENT OF NATURAL RESOURCES

Bureau of Land and Water Resources

Southport Mall

P.O. Box 10631

Jackson, Mississippi 39209

WATER WELL DRILLERS LOG

CODED

WAYNE
2257 73
3-12-86

3/12/86
date well completed

Layne - Central Co.
firm name

Wayne
county well located


LANDOWNER: Buckatunna
Water Assoc.
Buckatunna, MS -
(mailing address)
WELL LOCATION: SE 1/4 of NE 1/4 of SW 1/4
sec. 22 T 6 N R 5 E
3.5 miles South of Buckatunna
(distance) (direction) (nearest town)

description of formations encountered	from	to
Sandy clay	0'	15'
clay	15'	70'
Sand	70'	105'
Sandy clay	105'	194'
clay	194'	260'
Sandy clay	260'	332'
Hard clay	332'	340'
Sandy clay	340'	360'
clay	360'	417'
Rock	417'	421'
Clay & Lime	421'	460'
clay	460'	498'
Lime & Sand streaks	498'	520'
clay	520'	525'
Shale & Lime	525'	558'
clay	558'	590'
Lime (Hard)	590'	616'
Clay & Sand streaks	616'	702'
Rock	702'	704'
clay	704'	765'
Sand	765'	777'
Rock	777'	783'
Lime	783'	814'
Rock	814'	816'
clay	816'	820'
Rock	820'	821'
clay	821'	830'

WELL PURPOSE:
(home, irrigation, municipal, industrial)

WELL COMPLETION DATA:

- (1) diameter (inches) 12"
- (2) total depth (feet) 565'
- (3) static water level (feet) 37' below above top of ground.
- (4) casing Steel 531'
(material) (depth)
- 12" if telescope see back.
(size) 65' 4" of 6"
- (5) screen 30' 8" 531'
(length) (depth to top)
- 6" Stainless Steel
(size) (material)
- (6) pump 30 300
(HP) (yield gpm)
- electric
(type power)
- (7) electric log yes
(yes or no)
Layne - Central
(organization running log)
- (8) how well bottom plugged _____

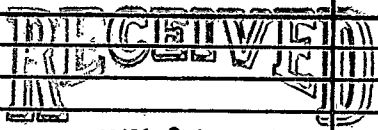

JUN 04 1986

Department of Natural Resources
Bureau of Land & Water Resources

DRILLERS REMARKS:

Engineer did not send # as requested.

