

MISSISSIPPI DEPARTMENT OF NATURAL RESOURCES

Bureau of Land and Water Resources

Southport Mall

P.O. Box 10631

Jackson, Mississippi 39209

WATER WELL DRILLERS LOG

Griner Drilling Service, Inc.

Wayne

CODED

295D

Wayne  
274

5-26-90 date well completed

Griner Drilling Service, Inc. firm name

Wayne county well located

LANDOWNER:

OXY, USA  
P.O. Box 12026  
Jackson, MS. 39326  
(mailing address)

description of formations encountered

from to

streaked clay 0 90

sand 90 170

Good sand 170 230

WELL LOCATION: 1850'S + 1700'E

Sec. 6 T. 60 N R. 5 E of  
No. 1 Hwy Buckatunga NW/CO  
1/4 (distance) (direction) of (nearest town)

WELL PURPOSE:

(home, irrigation, municipal, industrial)

WELL COMPLETION DATA:

(1) diameter (inches) 4"  
(2) total depth (feet) 230'  
(3) static water level (feet) Flowing top of ground.

(4) casing PVC, 230' - 190' (material) (depth)  
4" (size) if telescope see back.

(5) screen PVC 40' - 190' - 230' (length) (depth to top)  
4" (size) PVC slotted (material)

(6) pump 7 1/2 HP 80 (HP) (yield gpm)  
230 Volt 3phase (type power)

(7) electric log (yes or no)  no  
(organization running log)

(8) how well bottom plugged 4"  
plug + backwash valve

DRILLERS REMARKS:


RECEIVED

JUN 18 1990

Department of Natural Resources  
BUREAU OF LAND & WATER RESOURCES

If well telescopes please sketch and show depths.

GROUND LEVEL

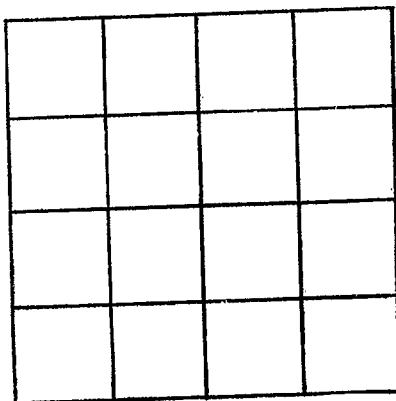

SECTION \_\_\_\_\_

Please indicate well location X.

ADDITIONAL INFORMATION

If more than one screen,  
show locations of each on sketch.