

Wayne
 Z 2000
 9-30-75

MISSISSIPPI
 BOARD OF WATER COMMISSIONERS
 416 North State Street
 Jackson, Mississippi 39201

WATER WELL DRILLERS LOG

9-30-75 CARRS well service WAYNE
 date well completed firm name county well located

LANDOWNER: Otto Buckley
RR1 Buckatonna Miss

description of formations encountered	from	to
TOP soil	0	1
yellow SAND	1	5
yellow & white clay	5	8
pink & yellow clay	8	11
yellow & white clay	11	18
purple clay	18	21
yellow clay	21	33
pink white & yellow clay	33	36
pink & white clay	36	39
Blue clay	39	40
ky Brown Rock yellow clay	40	44
Fine yellow to sand	44	47
yellow & pink clay	44	53
Fine yellow SD.	53	56
Blue clay	56	61
Fine yellow SD.	61	62
Blue clay	62	71
Fine white SD	71	74
CRAGISH clay	74	84
Fine white SD.	84	87
Blue clay	87	92
Fine white SD.	92	96
Bluish clay	96	139
med white SD	139	142
Blue clay	142	181
Blue & pink clay	181	194
Med white clay	194	210

(mailing address)

WELL LOCATION: 13P
 sec 3 T 6N R. 5E
1/4 miles SSE of Buc
 (distance) (direction) (nearest town)

WELL PURPOSE: Home
 (home, irrigation, municipal, industrial)

WELL COMPLETION DATA:

(1) diameter (inches) 4 1/2"

(2) total depth (feet) 210

(3) static water level (feet) 68 (below/above top of ground)

(4) casing PVC 200' (material) (depth)
 (size) if telescope see back.

(5) screen 10' 200' (length) (depth to top)
2" PVC 8 slot. (size) (material)

(6) pump 1 7 (HP) (yield gpm)
Elect (type power)

(7) electric log NO (yes or no)
 (organization running log)


(8) how well bottom plugged 2" SS
Back wash valve

DRILLERS REMARKS: Still in SAND when quit

OCT 23 1975
 MISS. Bd. OF WATER COMMISSIONERS

If well telescopes please sketch and show depths.

GROUND LEVEL

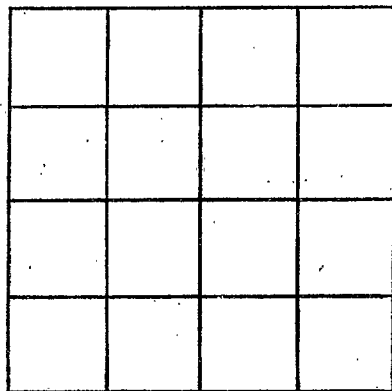

SECTION _____

Please indicate well location X.

ADDITIONAL INFORMATION

If more than one screen, show locations of each on sketch.