

WAYNE
 Z 2001
 2-2-76

MISSISSIPPI
 BOARD OF WATER COMMISSIONERS
 416 North State Street
 Jackson, Mississippi 39201

WATER WELL DRILLERS LOG

Feb 2 1976 Booth Drilling & Log Wayne
 date well completed firm name county well located

LANDOWNER: Wendy Brandy
 211 State Line Misc
 (mailing address)

description of formations encountered	from	to
red clay	0	30
blue clay		30
red clay	30	33
blue clay	33	60
red clay	60	62
blue clay	62	118
fine sand	118	160
coarse sand	160	166
Clay	166	167

WELL LOCATION:
 sec. 34 T. 6 N. R. 5 E. S. W
 1 miles N of State Line
 (distance) (direction) (nearest town)

WELL PURPOSE: Home
 (home, irrigation, municipal, industrial)

WELL COMPLETION DATA:
 (1) diameter (inches) 2
 (2) total depth (feet) 166
 (3) static water level (feet) 45 below top of ground.
 (4) casing PVC 161'
 (material) (depth)
2' If telescope see back.
 (size)
 (5) screen 5' 161'
 (length) (depth to top)
1 1/4" bed of SS
 (size) (material)
 (6) pump 1 12
 (HP) (yield gpm)
elec
 (type power)
 (7) electric log no
 (yes or no)
 (organization running log)


(8) how well bottom plugged
back valve

DRILLERS REMARKS:

RECEIVED
 FEB 18 1976
 MISSISSIPPI BOARD OF WATER COMMISSIONERS

If well telescopes please sketch and show depths.

GROUND LEVEL

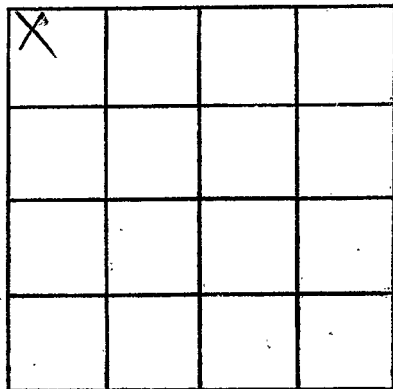

SECTION 34

Please indicate well location X.

ADDITIONAL INFORMATION

If more than one screen,
show locations of each on sketch.