

WAYNE

Z 2002

3-30-76

MISSISSIPPI  
 BOARD OF WATER COMMISSIONERS  
 416 North State Street  
 Jackson, Mississippi 39201

13P


WATER WELL DRILLERS LOG

3-30-76 date well completed CARRS well SERV firm name WAYNE county well located

LANDOWNER: <u>John BROWN</u>		description of formations encountered	from	to
<u>BUCATUNNA MISS 39322</u>				
(mailing address)				
WELL LOCATION:				
sec. <u>3</u> T. <u>6</u> (N) R. <u>5</u> (E)				
<u>X3</u> miles <u>South</u> of <u>Bear</u> (distance) (direction) (nearest town)				
WELL PURPOSE: <u>HOME</u>				
(home, irrigation, municipal, industrial)				
WELL COMPLETION DATA:				
(1) diameter (inches) <u>2"</u>				
(2) total depth (feet) <u>55</u>				
(3) static water level (feet) <u>35</u> <u>below</u> <u>above</u>				
(4) casing <u>PVC</u> <u>50</u>				
(material) (depth)				
(size) If telescope see back.				
(5) screen <u>4' 50</u>				
(length) (depth to top)				
<u>2"</u> <u>PVC 8510</u>				
(size) (material)				
(6) pump <u>1</u> <u>10</u>				
(HP) (yield gpm)				
<u>Elect</u>				
(type power)				
(7) electric log <u>No</u>				
(yes or no)				
(organization running log)				
(8) how well bottom plugged <u>2 BACK</u>				
<u>WASH VALVE</u>				

If well telescopes please sketch and show depths.

GROUND LEVEL

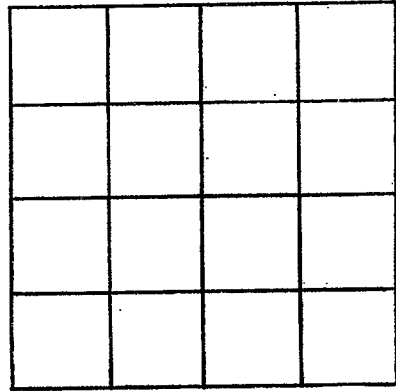

SECTION \_\_\_\_\_

Please indicate well location X.

ADDITIONAL INFORMATION

If more than one screen, show locations of each on sketch.