


Wayne
 E 2031
 4-5-76

MISSISSIPPI
 BOARD OF WATER COMMISSIONERS
 416 North State Street
 Jackson, Mississippi 39201

WATER WELL DRILLERS LOG

April 5, 1976 1976 date well completed
 RT. 2 BOX 31 WAYNESBORO, MISS. 39267
 McILWAIN WATER WELL SERVICE WAYNE county well located

LANDOWNER:	description of formations encountered	from	to
Mrs. FANNIE WHITE	Yellow Clay	0	5
RT 2 STATE LINE, MISS. (mailing address)	Fine Sand, some Clay	5	12
WELL LOCATION: sec. 5 T. 6 N R. 5 W 3 miles S of Bucatur (distance) (direction) (nearest town)	Coarse Sand	12	17
	Clay	17	19
WELL PURPOSE: HOME (home, irrigation, municipal, industrial)	Coarse Sand	19	32
WELL COMPLETION DATA:	med Sand	32	38
(1) diameter (inches) 2"			
(2) total depth (feet) 38'			
(3) static water level (feet) 25' below top of ground.			
(4) casing PVC 30' (material) (depth) 2" (size) If telescope see back.			
(5) screen 8' 30' (length) (depth to top) 2" PVC .008 (size) (material)			
(6) pump 1/2 10 (HP) (yield gpm) 110 AC (type power)			
(7) electric log NO (yes or no)			
(organization running log)			
(8) how well bottom plugged			
DRILLERS REMARKS:			

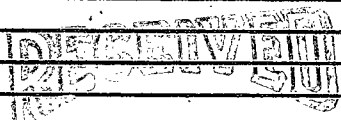


APR 20 1976

MISS. BU. OF WATER COMMISSIONERS

If well telescopes please sketch and show depths.

GROUND LEVEL

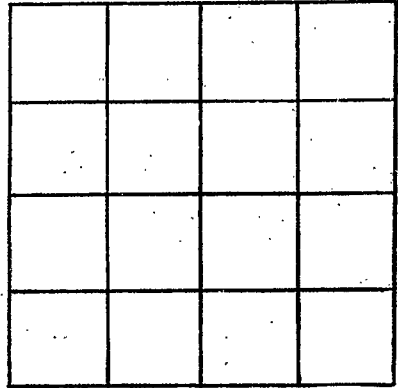

SECTION _____

Please indicate well location X.

ADDITIONAL INFORMATION

If more than one screen, show locations of each on sketch.