

WAYNE
 Z 2004
 6-2-76

MISSISSIPPI
 BOARD OF WATER COMMISSIONERS
 416 North State Street
 Jackson, Mississippi 39201

WATER WELL DRILLERS LOG

McILWAIN WATER WELL SERVICE

WAYNE


JUNE 2
 date well completed

1976

PT 2, BOX 27


WAYNESBORO, MISS. 39367

county well located

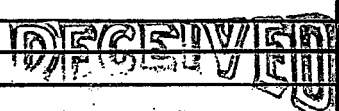LANDOWNER:	description of formations encountered	from	to
J. J. SEARS	Sandy Clay	0	3
WAYNESBORO, Miss. (mailing address)	Sand & Clay	3	12
WELL LOCATION: sec. 18 T. 6 N R. 5 E 3 1/2 miles NW State Line (distance) (direction) of (nearest town)	Sand	12	18
WELL PURPOSE: Hog Parlor (home, irrigation, municipal, industrial)			
WELL COMPLETION DATA:			
(1) diameter (inches) 2"			
(2) total depth (feet) 18'			
(3) static water level (feet) 3' below top of ground.			
(4) casing PVC 14' (material) (depth) 2" (size) if telescope see back.			
(5) screen 4' 14' (length) (depth to top)			
2" (size) PVC .008 (material)			
(6) pump 3/4 (HP) 10 (yield gpm)			
220 AC (type power)			
(7) electric log no (yes or no)			
(organization running log)			
(8) how well bottom plugged			
DRILLERS REMARKS:	 JUL 14 1976		

If well telescopes please sketch and show depths.

GROUND LEVEL

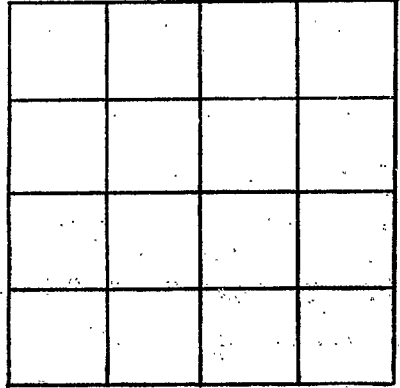

SECTION _____

Please indicate well location X.

ADDITIONAL INFORMATION

If more than one screen, show locations of each on sketch.