

WAYNE  
2000  
7-23-76

MISSISSIPPI  
 BOARD OF WATER COMMISSIONERS  
 416 North State Street  
 Jackson, Mississippi 39201

WATER WELL DRILLERS LOG

7/23 1976 Car's Well Dr. Wayne  
 date well completed firm name county well located

LANDOWNER: Arthur Croger  
State line,  
Miss.  
 (mailing address)

WELL LOCATION:  
 sec. 7 T-6 N R-5 E  
3 miles North of State Line  
 (distance) (direction) (nearest town)

WELL PURPOSE: Home  
 (home, irrigation, municipal, industrial)

- WELL COMPLETION DATA:
- (1) diameter (inches) 2"
  - (2) total depth (feet) 115"
  - (3) static water level (feet) 54 below top of ground.
  - (4) casing P.V.C. 110'  
 (material) (depth)  
2" If telescope see back.  
 (size)
  - (5) screen 5' 110'  
 (length) (depth to top)  
2" P.V.C. 8 slot  
 (size) (material)
  - (6) pump 1 7  
 (HP) (yield gpm)  
Electric  
 (type power)
  - (7) electric log NO  
 (yes or no)
  - (organization running log)
  - (8) how well bottom plugged 2"  
P.V.C. Cap.

Description of formations encountered	from to	
Top soil	0	1
yel. sand	1	3
11" clay	3	10
pk. "	10	16
Creamy clay	16	24
<del>Bl. clay</del>		
Bl. clay	24	28
Bl. Br. clay	28	33
Br. clay	33	42
Bl. yel. silt	42	46
Be. "	46	50
yel. "	50	58
Bl. + yel. "	58	62
fine w. sand	62	64
Bl. + yel. clay	64	70
fine w. sand	70	78
med. w. "	78	95
Coarse " "	95	115
Bl. clay	115	117


RECEIVED  
 JUL 28 1976

MISS. BD. OF WATER COMMISSIONERS

DRILLERS REMARKS:

If well telescopes please sketch and show depths.

GROUND LEVEL

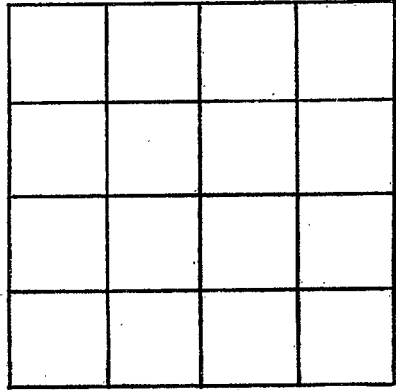

SECTION \_\_\_\_\_

Please indicate well location X.

ADDITIONAL INFORMATION

If more than one screen, show locations of each on sketch.