

WAYNE
 7-22-76

MISSISSIPPI
 BOARD OF WATER COMMISSIONERS
 416 North State Street
 Jackson, Mississippi 39201

WATER WELL DRILLERS LOG

7-22-76 date well completed
 13 P 76 CARRS well serv firm name
 WAYNE county well located

LANDOWNER: HIRAM Miller
State Line Miss
 (mailing address)

WELL LOCATION:
 sec. 28 T-6 N R-5 E S
 2 1/2 miles North of State Line (distance) (direction) (nearest town)

WELL PURPOSE: Home
 (home, irrigation, municipal, industrial)

- WELL COMPLETION DATA:
- (1) diameter (inches) 3"
 - (2) total depth (feet) 70'
 - (3) static water level (feet) 42 ^{below}/_{above} top of ground.
 - (4) casing P.V.C. 65' (material) (depth)
2" (size) If telescope see back.
 - (5) screen 5' 65' (length) (depth to top)
2" P.V.C. 8 slot (size) (material)
 - (6) pump 1 (HP) 10 gal. (yield gpm)
Elec. (type power)
 - (7) electric log NO (yes or no)
 - (organization running log)
 - (8) how well bottom plugged 2" P.V.C. cap.


description of formations encountered	from to	
	ft	ft
Top Soil	0	1
yellow SAND	1	2
yellow CLAY	2	5
Pink CLAY	5	15
Yellow & white CLAY	15	18
yellow ROCKS	18	19
white CLAY	19	22
Fine yellow SAND	22	30
Yellow & white CLAY	30	35
white CLAY	35	40
Med. w. Sand	40	43
Blue clay	43	50
Bl. yellow pl. clay	50	55
Broken fine white sand	55	62
Cr. w. Sand	62	70

DRILLERS REMARKS: Still in sand when quit

RECEIVED
 JUL 28 1976

If well telescopes please sketch and show depths.

GROUND LEVEL

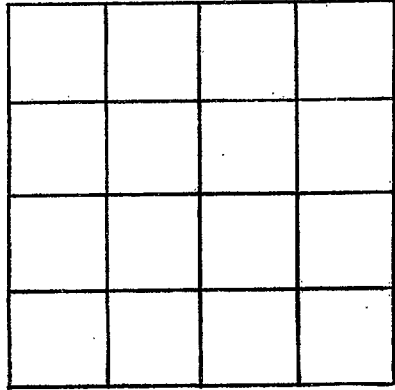

SECTION _____

Please indicate well location X.

ADDITIONAL INFORMATION

If more than one screen, show locations of each on sketch.