

Wayne
 Z 5008
 9/24/76

MISSISSIPPI
 BOARD OF WATER COMMISSIONERS
 416 North State Street
 Jackson, Mississippi 39201

WATER WELL DRILLERS LOG

9-24 1976 CARRS well service WAYNE
 date well completed firm name county well located

LANDOWNER: Glen Wells
State Line Miss
RT 2
 (mailing address)

WELL LOCATION:
 sec. 23 T. 6N R. 5E
S W
4 1/2 miles South of Buc
 (distance) (direction) (nearest town)

WELL PURPOSE: Home
 (home, irrigation, municipal, industrial)

WELL COMPLETION DATA:

(1) diameter (inches) 2"

(2) total depth (feet) 94

(3) static water level (feet) 30' below above top of ground.

(4) casing PVC 89
 (material) (depth)
 (size) if telescope see back.

(5) screen 5' 89'
 (length) (depth to top)
2" PVC (8 slot)
 (size) (material)

(6) pump 1 10
 (HP) (yield gpm)
Elect
 (type power)

(7) electric log (yes or no) _____
 (organization running log) _____

(8) how well bottom plugged 2" CAP


description of formations encountered	from to	
Top Soil	0	1
yellow CLAY	1	8
Med yellow sand	8	12
BROWN ROCK	12	15
Pink & white CLAY	15	22
Bluish CLAY	22	27
yellow & white CLAY	27	32
yellow CLAY	32	34
Broken white CLAY &		
Fine white sand	34	44
yellow CLAY	44	46
Bluish CLAY	46	62
Fine white SD	62	80
Med white SD	80	87
Coarse white SD	87	94

DRILLERS REMARKS: still in sand when quit DRIG

RECEIVED
 OCT 2 4 1976

If well telescopes please sketch and show depths.

GROUND LEVEL

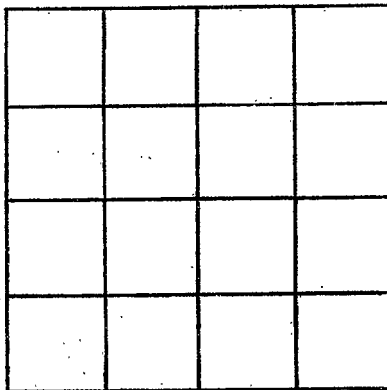

SECTION _____

Please indicate well location X.

ADDITIONAL INFORMATION

If more than one screen, show locations of each on sketch.