

Wayne  
 7 2010  
 8/26/76

MISSISSIPPI  
 BOARD OF WATER COMMISSIONERS  
 416 North State Street  
 Jackson, Mississippi 39201

13P  
 WATER WELL DRILLERS LOG  
 McILWAIN WATER WELL SERVICE

Aug 26, 1976  
 date well completed

PT 2, BOX 37

WAYNESBORO, MISS. 39367

Wayne  
 county well located


LANDOWNER:	description of formations encountered	from	to
Gladys Louise Johnson	Red Clay	0	8
Waynesboro, Miss. (mailing address)	Mixed Clay	8	71
WELL LOCATION:	Sand	71	75
sec. 17 T. 6 N R. 5 E 4 miles S of BUCATUNNA (distance) (direction) (nearest town)	Clay	75	95
WELL PURPOSE: HOME (home, irrigation, municipal, industrial)	Sand + Clay	95	110
WELL COMPLETION DATA:	Fine Sand	110	130
(1) diameter (inches) 2"	Med Sand	130	145
(2) total depth (feet) 145'			
(3) static water level (feet) 74' below top of ground.			
(4) casing PVC 137' (material) (depth)			
2" If telescope see back. (size)			
(5) screen 8' 137' (length) (depth to top)			
2" PVC .008 (size) (material)			
(6) pump 1 6 (HP) (yield gpm)			
220 AC (type power)			
(7) electric log NO (yes or no)			
(organization running log)			
(8) how well bottom plugged			
DRILLERS REMARKS:			

RECEIVED  
 OCT - 5 1976

MISS. BO. OF WATER COMMISSIONERS

If well telescopes please sketch and show depths.

GROUND LEVEL

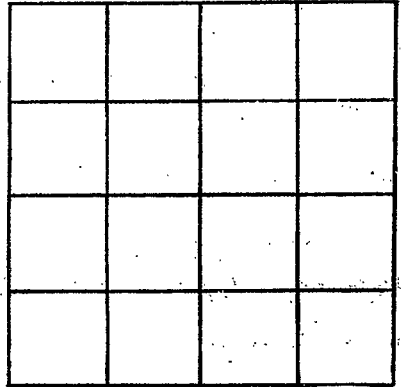

SECTION \_\_\_\_\_

Please indicate well location X.

ADDITIONAL INFORMATION

If more than one screen, show locations of each on sketch.