

Wayne  
 2 3/4  
 9/21/76

MISSISSIPPI  
 BOARD OF WATER COMMISSIONERS  
 416 North State Street  
 Jackson, Mississippi 39201

WATER WELL DRILLERS LOG

9-21 1976 ~~1976~~ CARRS well service WAYNE  
 date well completed firm name county well located

LANDOWNER: A.C. Batters  
 Rt 2 State Line Miss  
 (mailing address)

WELL LOCATION:  
 sec. 17 T-6 N S R-5 E W  
 4 miles south of Buc  
 (distance) (direction) (nearest town)

WELL PURPOSE: Home  
 (home, irrigation, municipal, industrial)

- WELL COMPLETION DATA:
- (1) diameter (inches) 2"
  - (2) total depth (feet) 170
  - (3) static water level (feet) 80 (below top of ground)
  - (4) casing PVC, 160 (material) (depth)  
 (size) if telescope see back.
  - (5) screen 10', 160 (length) (depth to top)  
 2" PVC 8 slot (size) (material)
  - (6) pump 1 (HP) 6 (yield gpm)  
 Elect (type power)
  - (7) electric log No (yes or no)  
 (organization running log)
  - (8) how well bottom plugged 3" Cap


description of formations encountered	from to	
TOP Soil	0	1
Reddish CLAY	1	8
white CLAY	8	19
Fine white SAND	19	24
yellow+white CLAY	24	30
BROWN Rock+Pink+		
white CLAY	30	34
Yellow CLAY	34	39
Bluish CLAY	39	50
Pink+Bluish CLAY	50	54
Bluish CLAY	54	90
Coarse white sd	90	93
Bluish CLAY	93	97
Fine white SAND	97	107
Blue CLAY	107	125
Fine Fine white sd	125	145
Fine white sd	145	159
Coarse white sd	159	170

DRILLERS REMARKS: still in sand when quit DRIG

RECEIVED  
 OCT 14 1976

If well telescopes please sketch and show depths.

GROUND LEVEL

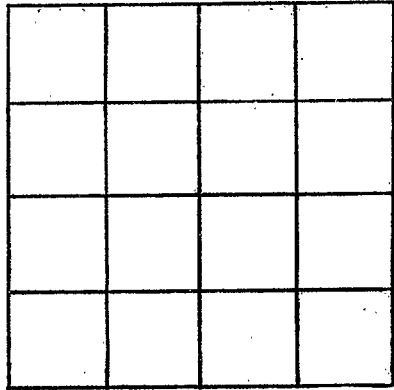

SECTION \_\_\_\_\_

Please indicate well location X.

ADDITIONAL INFORMATION

If more than one screen, show locations of each on sketch.