

Wayne
 E 2013
 11-8-76

MISSISSIPPI
 BOARD OF WATER COMMISSIONERS
 416 North State Street
 Jackson, Mississippi 39201

WATER WELL DRILLERS LOG

Nov. 8 1976 Carter Drilling & Log Wayne
 date well completed firm name county well located

LANDOWNER: Edland
Carthwright
At 1 Bushkatenna Miss
 (mailing address)

description of formations encountered	from	to
red sand & clay	0	12
clay	12	15
mostly sand	15	52
clay	52	67
fine sand	67	103
light m. chalky sand		

WELL LOCATION:
 sec. 4 T 6 N R. 5 E
3 miles SE of Bushkatenna
 (distance) (direction) (nearest town)

description of formations encountered	from	to
4 1/2" 7 slot S.S. screen		
screen on end of cas		
most shell top above		
7 1/4" back wash valve		
on end		
91' 1" P.V.C. large		
pipe		

WELL PURPOSE: home
 (home, irrigation, municipal, industrial)

description of formations encountered	from	to
4 1/2" 7 slot S.S. screen		
screen on end of cas		
most shell top above		
7 1/4" back wash valve		
on end		
91' 1" P.V.C. large		
pipe		

WELL COMPLETION DATA:
 (1) diameter (inches) 2"
 (2) total depth (feet) 103'
 (3) static water level (feet) 72 (below/above top of ground)
 (4) casing P.V.C. 99'
 (material) (depth)
2" (size) if telescope see back.
 (5) screen 4" 99'
 (length) (depth to top)
1 1/2" 7 slot S.S.
 (size) (material)
 (6) pump 1 1/2 9
 (HP) (yield gpm)
elec.
 (type power)
 (7) electric log no
 (yes or no)
 (organization running log)

description of formations encountered	from	to
4 1/2" 7 slot S.S. screen		
screen on end of cas		
most shell top above		
7 1/4" back wash valve		
on end		
91' 1" P.V.C. large		
pipe		

(8) how well bottom plugged:
back wash valve


DRILLERS REMARKS:

RECEIVED
 DEC 6 1976

MISS. BD. OF WATER COMMISSIONERS

If well telescopes please sketch and show depths.

GROUND LEVEL

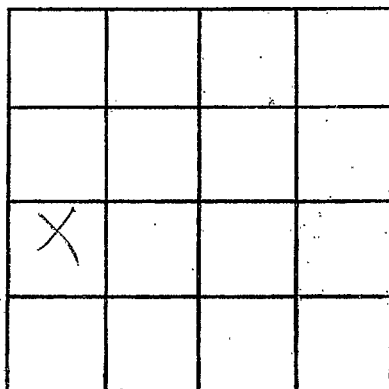

SECTION 4

Please indicate well location X.

ADDITIONAL INFORMATION

If more than one screen,
show locations of each on sketch.