

Wayne  
 Z 2015  
 12-27-76

MISSISSIPPI  
 BOARD OF WATER COMMISSIONERS  
 416 North State Street  
 Jackson, Mississippi 39201

WATER WELL DRILLERS LOG

12-27 1976 CHARRS well SERV WAYNE  
 date well completed firm name county well located

LANDOWNER: Dorthy Burney  
 State Line MS

(mailing address)

WELL LOCATION:  
 sec 27 T 60 N R 5 E  
 S (W) 2  
 1/2 miles Soutg of Fret  
 (distance) (direction) (nearest town)

WELL PURPOSE: Home  
 (home, irrigation, municipal, industrial)

WELL COMPLETION DATA:

- (1) diameter (inches) 2"
- (2) total depth (feet) 70
- (3) static water level (feet) 40 below top of ground.
- (4) casing pvc, 66' (material) (depth)
- (size) If telescope see back.
- (5) screen 4' 66' (length) (depth to top)
- 1/4 steel slot (size) (material) MS
- (6) pump 1/2 5 (HP) (yield gpm)
- elect (type power)
- (7) electric log No (yes or no)
- (organization running log)

(8) how well bottom plugged 1/4 galn Pulley

DRILLERS REMARKS: Tested @ 8:30 PM


description of formations encountered	from	to
TOP Soil	0	1
Yellow SD	1	3
Yellow CLAY	3	6
PINK+white CLAY	6	10
PINK+white+yellow CLAY	10	13
Fine yellow SD	17	19
yellow CLAY	19	25
yellow+white CLAY	25	27
Blue CLAY	27	29
Fine white SD	29	35
Blue CLAY	35	57
Fine white SD	57	65
Blue CLAY	65	67
COARSE white SD	67	70
Blue CLAY	70	72

RECEIVED  
 FEB 10 1977

MISS. BD. OF WATER COMM

If well telescopes please sketch and show depths.

GROUND LEVEL

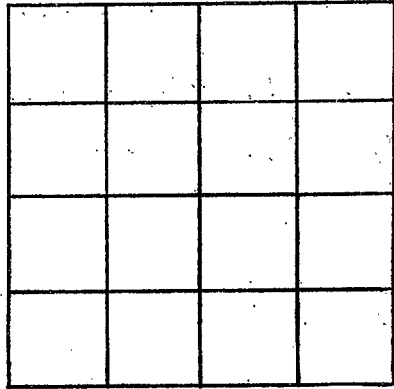

SECTION \_\_\_\_\_

Please indicate well location X.

ADDITIONAL INFORMATION

If more than one screen, show locations of each on sketch.