

WAYNE
Z 2016
1-2-77

MISSISSIPPI
BOARD OF WATER COMMISSIONERS
416 North State Street
Jackson, Mississippi 39201

13P

WATER WELL DRILLERS LOG

Jan 2 1977 Porter Drilling Log Wayne
date well completed firm name county well located

LANDOWNER: William H. Beasley
Box 1 Buckatanna
(mailing address)

WELL LOCATION:
sec. 6 T 6 N R 5 E
1 miles S of Buckatanna
(distance) (direction) (nearest town)

WELL PURPOSE: Home
(home, irrigation, municipal, industrial)

WELL COMPLETION DATA:
(1) diameter (inches) 2"
(2) total depth (feet) 169'
(3) static water level (feet) 15' below above top of ground.
(4) casing PVC 165'
(size) (material) (depth)
2" If telescope see back.
(5) screen 4' 165'
(length) (depth to top)
2" slit S.S.
(size) (material)
(6) pump 1/2 12
(HP) (yield gpm)
elec. power flow 10 gal
(type power)
(7) electric log no
(yes or no)
(organization running log)
(8) how well bottom plugged backwash valve

description of formations encountered	depth	
	from	to
<u>sand</u>	<u>0</u>	<u>12</u>
<u>clay</u>	<u>12</u>	<u>47</u>
<u>sand</u>	<u>47</u>	<u>52</u>
<u>clay</u>	<u>52</u>	<u>145</u>
<u>sand with some coarse shell or clay</u>	<u>145</u>	<u>169</u>

RECEIVED


FEB - 7 1977

DRILLERS REMARKS:

MISS. BD. OF WATER COMMISSIONERS

If well telescopes please sketch and show depths.

GROUND LEVEL

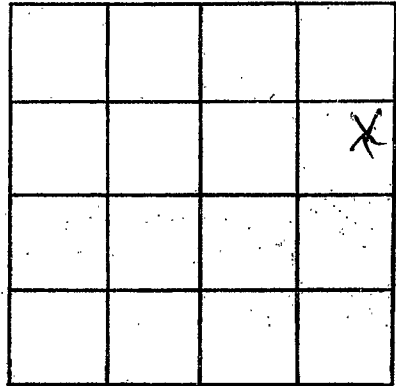

SECTION 6

Please indicate well location X.

ADDITIONAL INFORMATION

If more than one screen,
show locations of each on sketch.