

WAYNE
Z 207
3-17-77

MISSISSIPPI
 BOARD OF WATER COMMISSIONERS
 416 North State Street
 Jackson, Mississippi 39201

WATER WELL DRILLERS LOG

March 17 1977 *Robert Drilling* Wayne
 date well completed firm name county well located

LANDOWNER: *Tom Hattwell* description of formations encountered from to

Off State Line Min
 (mailing address)

WELL LOCATION:
 sec 23 T 6 N R 5 E
3 1/2 miles N of State Line
 (distance) (direction) (nearest town)

WELL PURPOSE: home
 (home, irrigation, municipal, industrial)

WELL COMPLETION DATA:

- (1) diameter (inches) 2"
- (2) total depth (feet) 165"
- (3) static water level (feet) 150 below above top of ground.
- (4) casing PVC 160'
 (material) (depth)
- 2"
 (size) If telescope see back.
- (5) screen 5' 160'
 (length) (depth to top)
- 2" Galv. S.S.
 (size) (material)
- (6) pump 1 rod 3 1/2
 (HP) (yield gpm)
- elec.
 (type power)
- (7) electric log no
 (yes or no)
- (organization running log)

<i>red clay + sand</i>	<i>0</i>	<i>18</i>
<i>clay</i>	<i>18</i>	<i>93</i>
<i>sand</i>	<i>93</i>	<i>95</i>
<i>sand + clay</i>	<i>95</i>	<i>105</i>
<i>clay</i>	<i>105</i>	<i>150</i>
<i>red clay</i>	<i>150</i>	<i>159</i>
<i>red sand</i>	<i>159</i>	<i>165</i>

stop on clay

1 1/2" charge gauge 165'

walk cylinder on end

165' 2" sucker rods

steel trap, above screen

and 1 1/2" back wash

valve on end

RECEIVED

APR 6 1977


MISS. BD. OF WATER COMM.

(8) how well bottom plugged 1 1/2" back

DRILLERS REMARKS:

If well telescopes please sketch and show depths.

GROUND LEVEL

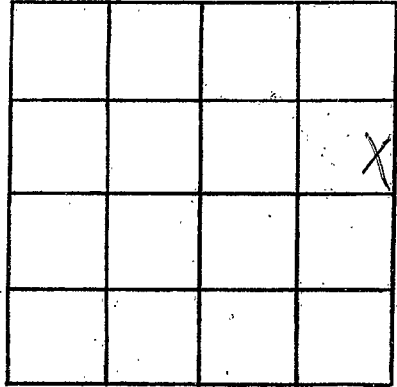

SECTION 23

Please indicate well location X.

ADDITIONAL INFORMATION

If more than one screen, show locations of each on sketch.