

WAYNE
 2 2012
 6-2-77

MISSISSIPPI
 BOARD OF WATER COMMISSIONERS
 416 North State Street
 Jackson, Mississippi 39201

WATER WELL DRILLERS LOG

June 2 1977 date well completed
 Porter Drilling Co firm name
 Wayne county well located

LANDOWNER: BA Melvin

description of formations encountered	from	to
clay	0	10
sand	15	30
clay	30	46
sand & clay	46	64
clay	64	105
sand & clay	105	135
sand & clay	135	149
clay	149	220
sand & some clay	220	241
sand	241	261
stop on clay		

241 State Line Miss (mailing address)

WELL LOCATION:

sec 14 T 6 N R 5 E
 4 miles SE of Bickatum (nearest town)

WELL PURPOSE: home (home, irrigation, municipal, industrial)

WELL COMPLETION DATA:

- (1) diameter (inches) 2'
- (2) total depth (feet) 261'
- (3) static water level (feet) 8' below top of ground
- (4) casing P.V.C. 2.5" (material) 251' (depth)
- (5) screen 2' (size) if telescope see back. 10' 2.5" (length) (depth to top)
- (6) pump flow 14 (HP) (yield gpm)
- (7) electric log (yes or no)
- (organization running log)

1/4" back wash valve


DRILLERS REMARKS:

RECEIVED
 JUL 9 1977

MISS. BD. OF WATER COMM.

If well telescopes please sketch and show depths.

GROUND LEVEL

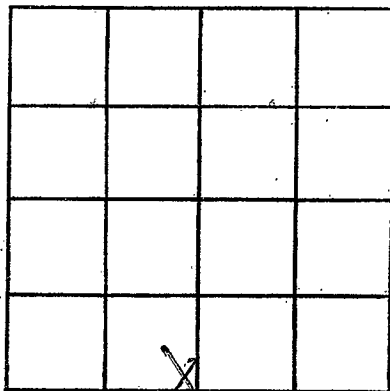

SECTION 14

Please indicate well location X.

ADDITIONAL INFORMATION

If more than one screen, show locations of each on sketch.