

WAYNE
Z 209
7-21-77

MISSISSIPPI
BOARD OF WATER COMMISSIONERS
416 North State Street
Jackson, Mississippi 39201

WATER WELL DRILLERS LOG

7-21-77 date well completed 13P 77 CARRS well service firm name Wayne county well located

LANDOWNER: J. S. Colwell
Pt. 1
State Line, Ms.
(mailing address)

WELL LOCATION:
sec. 9 T. 6(N) S R. 5 E W
3 miles S of Puckettville
(distance) (direction) (nearest town)

WELL PURPOSE: home
(home, irrigation, municipal, industrial)

WELL COMPLETION DATA:
(1) diameter (inches) 2"
(2) total depth (feet) 54'
(3) static water level (feet) 42' below above top of ground.
(4) casing P.V.C. 49' (material) (depth)
2' if telescope see back. (size)
(5) screen 5' 49' (length) (depth to top)
2" P.V.C. 85. (size) (material)
(6) pump 1/2 HP 7 (HP) (yield gpm)
Elec. (type power)
(7) electric log NO (yes or no)
(organization running log)
(8) how well bottom plugged 2" P.V.C. cap


description of formations encountered	from	to
T. Soil	0	1
ex. y. pk. sand	1	6
gl. y. pk. + w. clay	6	15
w. + pk. clay	15	35
w. clay	35	42
Coarse yellow sand	42	54

RECEIVED
JUL 29 1977
MISS. BD. OF WATER COMMISSIONERS

DRILLERS REMARKS:

If well telescopes please
sketch and show depths.

GROUND LEVEL

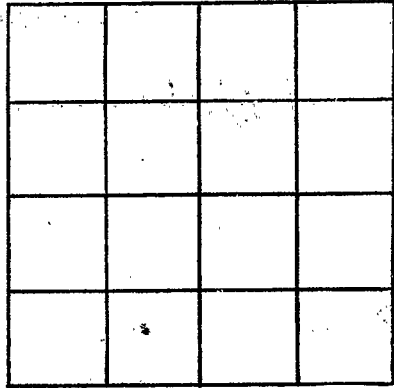

SECTION _____

Please indicate well location X.

ADDITIONAL INFORMATION

If more than one screen,
show locations of each on sketch.