

WAYNE

Z 2022

17-22-77

MISSISSIPPI BOARD OF WATER COMMISSIONERS  
416 North State Street  
Jackson, Mississippi 39201

WATER WELL DRILLERS LOG  
McILWAIN WATER WELL SERVICE

Nov. 22 1977  
date well completed

RT. 2, BOX 37  
WAYNESBORO, MISS. 39367

WAYNE  
county well located


LANDOWNER:	description of formations encountered	from	to
Alice Gee Mitchell	Clay	0	5
Waynesboro Miss. (mailing address)	Sand	5	15
WELL LOCATION: sec. 8 T. 16 N R. 5 E 2 miles SE of Buckatunna	Clay	15	18
(distance) (direction) (nearest town)	Coarse Sand	18	30
WELL PURPOSE: Home (home, irrigation, municipal, industrial)	Med. Sand	30	42
WELL COMPLETION DATA:			
(1) diameter (inches) 2"			
(2) total depth (feet) 42'			
(3) static water level (feet) 26 below top of ground.			
(4) casing PVC 37' (material) (depth)			
2" (size) if telescope see back.			
(5) screen 5' 37' (length) (depth to top)			
2" PVC, 008 (size) (material)			
(6) pump 1 12 (HP) (yield gpm)			
220 AC (type power)			
(7) electric log No (yes or no)			
organization running log			
well bottom plugged			
MARKS:			

RECEIVED  
APR 24 1978

MISS. BD. OF WATER COMMISSIONERS

If well telescopes please sketch and show depths.

GROUND LEVEL

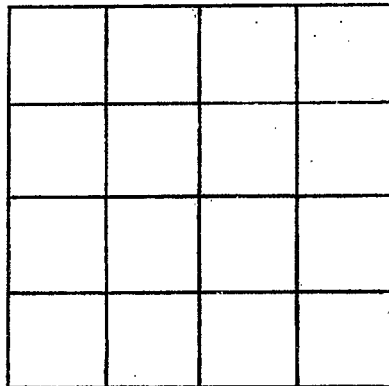


SECTION \_\_\_\_\_

Please indicate well location X.

ADDITIONAL INFORMATION

If more than one screen, show locations of each on sketch.

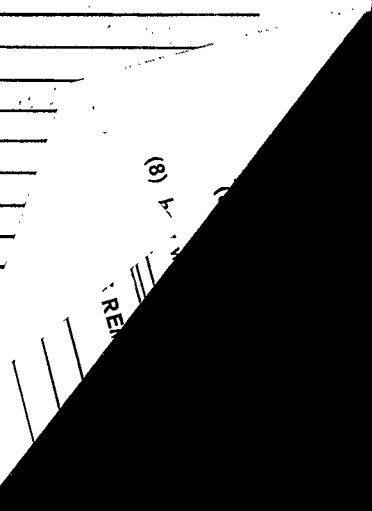

(8)

RE