

WAYNE
 2 2023
 3-9-78

MISSISSIPPI
 BOARD OF WATER COMMISSIONERS
 416 North State Street
 Jackson, Mississippi 39201

WATER WELL DRILLERS LOG

MILWAUIN WATER WELL SERVICE

March 9 1978 date well completed
 RT. 2 from north Box 37
 WAYNESBORO, MISS. 39367
 Wayne county well located

LANDOWNER:
 Arthur Cropper
 Waynesboro Miss
 (mailing address)

description of formations encountered	from	to
Sandy Clay	0	8
Clay	8	15
Sand	15	18
Clay	18	48
Sand	48	70

WELL LOCATION:
 sec. 21 T. 6 N R. 5 E
 2 miles NW of State Line
 (distance) (direction) (nearest town)

WELL PURPOSE: Home
 (home, irrigation, municipal, industrial)

- WELL COMPLETION DATA:
- (1) diameter (inches) 2"
 - (2) total depth (feet) 70'
 - (3) static water level (feet) 26' below above top of ground.
 - (4) casing PVC 65' (material) (depth)
 2" (size) If telescope see back.
 - (5) screen 5' 65' (length) (depth to top)
 2" PVC .068 (size) (material)
 - (6) pump 1 10 (HP) (yield gpm)
 220 AC (type power)
 - (7) electric log No (yes or no)
 - (organization running log)
 - (8) how well bottom plugged


DRILLERS REMARKS:

RECEIVED
 APR 24 1978

MISS. BD. OF WATER COMM

If well telescopes please
sketch and show depths.

GROUND LEVEL

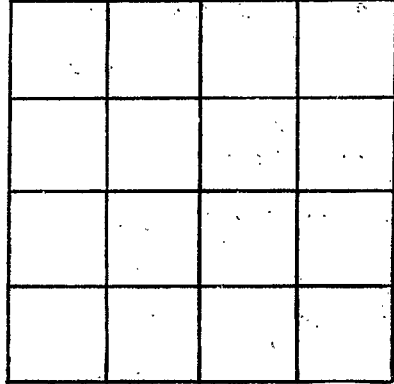

SECTION _____

Please indicate well location X.

ADDITIONAL INFORMATION

If more than one screen,
show locations of each on sketch.