

WAYNE  
Z  
5-8-78

MISSISSIPPI  
BOARD OF WATER COMMISSIONERS  
416 North State Street  
Jackson, Mississippi 39201

WATER WELL DRILLERS LOG

May 8 1978 *Herstels Well Ser.* *Wayne*  
date well completed firm name county well located

LANDOWNER: *James Odom*  
*State Line, Miss.*  
(mailing address)  
WELL LOCATION:  
sec. 27 T. 6 (N) R. 5 E  
S W  
1 miles *North* of *State Line*  
(distance) (direction) (nearest town)

description of formations encountered	from	to
<i>topsoil</i>	0	1
<i>red sand</i>	1	3
<i>red clay</i>	3	38
<i>white clay</i>	38	92
<i>clay with sand str</i>	92	138
<i>grey clay</i>	138	170
<i>blue clay</i>	170	201
<i>clay with sand str</i>	201	249
<i>sand med to coarse</i>	249	275

WELL PURPOSE:  
(home, irrigation, municipal, industrial)

WELL COMPLETION DATA:  
(1) diameter (inches) *2"*  
(2) total depth (feet) *275 ft.*  
(3) static water level (feet) *90 ft.* <sup>below</sup> <sub>above</sub> top of ground.  
(4) casing *P.V.C.* *265 ft.*  
(material) (depth)  
If telescope see back.  
(size)  
(5) screen *10 ft.* *265 ft.*  
(length) (depth to top)  
*2"* *P.V.C.*  
(size) (material)  
(6) pump *1* *4*  
(HP) (yield gpm)  
*electric*  
(type power)  
(7) electric log *no*  
(yes or no)  
(organization running log)  
(8) how well bottom plugged *back*  
*wash valve*


RECEIVED  
JUN - 7 1978

MISS. DD. OF WATER COMMISSIONERS

DRILLERS REMARKS: *Well tested 15 gpm with pump on rig*

If well telescopes please sketch and show depths.

GROUND LEVEL

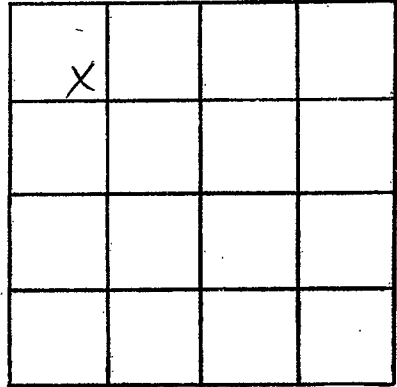

SECTION 26

Please indicate well location X.

ADDITIONAL INFORMATION

If more than one screen, show locations of each on sketch.