

WAYNE
 2000
 7-18-78

MISSISSIPPI
 BOARD OF WATER COMMISSIONERS
 416 North State Street
 Jackson, Mississippi 39201

WATER WELL DRILLERS LOG
 McILWAIN WATER WELL SERVICE

July 18 19 78
 date well completed

RT. 2, BOX 37
 WAYNESBORO, MISS. 39367

WAYNE
 county well located


LANDOWNER:	description of formations encountered	from	to
George Smith State Line (mailing address)			
WELL LOCATION:	Clay	5	25
sec. 22 T. 6 N. R. 5 E. W. 3 (distance) miles (direction) of (nearest town)	fine Sand	25	28
WELL PURPOSE: Home (home, irrigation, municipal, industrial)	Clay	28	50
WELL COMPLETION DATA:	Med Sand	50	59
(1) diameter (inches) 2"			
(2) total depth (feet) 59'			
(3) static water level (feet) 33' below above top of ground.			
(4) casing PVC 54' (material) (depth)			
2" if telescope see back. (size)			
(5) screen 5' 54' (length) (depth to top)			
2" PVC 008 (size) (material)			
(6) pump 1 10 (HP) (yield gpm)			
220 AC (type power)			
(7) electric log No (yes or no)			
(organization running log)			
(8) how well bottom plugged			
DRILLERS REMARKS:			

RECEIVED
 AUG 11 1978

MISS. BD. OF WATER COMM.

For well telescopes please
sketch and show depths.

GROUND LEVEL

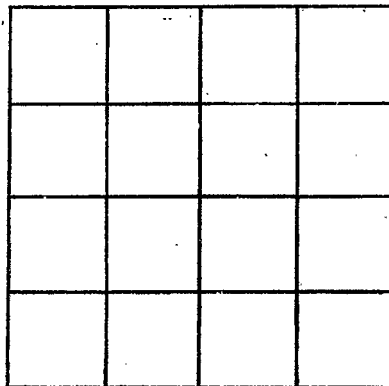

SECTION _____

Please indicate well location X.

ADDITIONAL INFORMATION

If more than one screen,
show locations of each on sketch.