

WAYNE
Zone
7-1-78

MISSISSIPPI
BOARD OF WATER COMMISSIONERS
416 North State Street
Jackson, Mississippi 39201

WATER WELL DRILLERS LOG
McILWAIN WATER WELL SERVICE

July 1 19 78 RT. 2 BOX 37 WAYNE
date well completed WAYNESBORO, MISS. 39367 county well located

LANDOWNER: John Bivens
WAYNESBORO, MS.
(mailing address)

description of formations encountered	from	to
Clay	0	14
SAND & CLAY	14	18
SAND	18	24

WELL LOCATION:
sec. 8 T 6 N R 5
4 miles SE of BUNNA
(distance) (direction) (nearest town)

WELL PURPOSE: Home
(home, irrigation, municipal, industrial)

WELL COMPLETION DATA:

(1) diameter (inches) 2"

(2) total depth (feet) 24'

(3) static water level (feet) 13' below top of ground.

(4) casing PVC 19' (material) (depth)
2" (size) If telescope see back.


(5) screen 5' 19' (length) (depth to top)
2" PVC .008 (size) (material)

(6) pump 3/4 8 (HP) (yield gpm)
220 AC (type power)

(7) electric log NO (yes or no)

(organization running log)

(8) how well bottom plugged

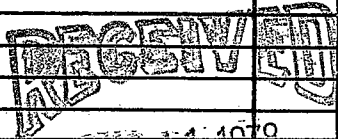

AUG 11 1978

DRILLERS REMARKS:

MISS. BD. OF WATER COMM

If well telescopes please sketch and show depths.

GROUND LEVEL

SECTION _____

Please indicate well location X.

ADDITIONAL INFORMATION

If more than one screen, show locations of each on sketch.