

WAYNE  
 Z 2029  
 6629-79

MISSISSIPPI  
 BOARD OF WATER COMMISSIONERS  
 416 North State Street  
 Jackson, Mississippi 39201

WATER WELL DRILLERS LOG  
 McILWAIN WATER WELL SERVICE

6-29 1979 date well completed  
 RT. 2 BOX 37 WAYNESBORO, MISS. 39367  
 Wayne county well located

LANDOWNER:	description of fomations encountered	from	to
Gerald Ferguson	Red Sand	0	3
Waynesboro, Miss. (mailing address)	Clay	3	5
WELL LOCATION: sec 16 T 6 N R 5 E 6 miles SE of B. Tunna (distance) (direction) (nearest town)	Sandy Clay	5	8
WELL PURPOSE: Home (home, irrigation, municipal, industrial)	Fine Sand + Clay	8	18
WELL COMPLETION DATA: (1) diameter (inches) 2" (2) total depth (feet) 79' (3) static water level (feet) 33' below top of ground. (4) casing PVC 74' (material) (depth) 2" (size) If telescope see back. (5) screen 5' 74' (length) (depth to top) 2" PVC .008 (size) (material) (6) pump 1 15 (HP) (yield gpm) 220 AC (type power) (7) electric log No (yes or no) (organization running log) (8) how well bottom plugged	Clay	18	21
	Med. White Sand	21	24
	Sand & Clay	24	28
	Clay	28	34
	Blue Clay + Sand	34	54
	Med - Coarse Sand	54	56
	Sand + Clay	56	61
	Coarse Sand	61	79

Miss. Board of Water Comm.


AUG 6 1979

RECEIVED

DRILLERS REMARKS:

If well telescopes please sketch and show depths.

GROUND LEVEL

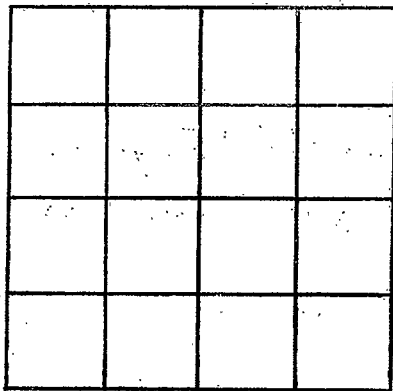

SECTION \_\_\_\_\_

Please indicate well location X.

ADDITIONAL INFORMATION

If more than one screen, show locations of each on sketch.