

Wayne  
2031  
7-10-79

MISSISSIPPI  
 BOARD OF WATER COMMISSIONERS  
 416 North State Street  
 Jackson, Mississippi 39201

WATER WELL DRILLERS LOG

July 10 1979 Porter Drilling Wayne  
 date well completed firm name county well located

LANDOWNER: Cliff Duman  
Off Hwy 38  
State Line Miss  
 (mailing address)  
 WELL LOCATION:  
 sec 15 T 6 N R 5 E  
11 miles SE of Buckatun  
 (distance) (direction) (nearest town)

| description of formations encountered | from | to  |
|---------------------------------------|------|-----|
| clay & sand                           | 0    | 20  |
| clay                                  | 20   | 81  |
| fine sand                             | 81   | 98  |
| med coarse sand                       | 98   | 102 |
| silt sand & clay                      | 102  | 108 |
| sand med to fine                      | 108  | 113 |
| stop in fine sand                     |      |     |

WELL PURPOSE: Home  
 (home, irrigation, municipal, industrial)

WELL COMPLETION DATA:  
 (1) diameter (inches) 2"  
 (2) total depth (feet) 115'  
 (3) static water level (feet) 75' below top of ground.  
 (4) casing PVC 110'  
 (material) (depth)  
2"  
 (size) if telescope see back.  
 (5) screen 5' 110'  
 (length) (depth to top)  
2" 6 alt S.S.  
 (size) (material)  
 (6) pump 1 7  
 (HP) (yield gpm)  
elec  
 (type power)  
 (7) electric log no  
 (yes or no)  
 (organization running log)  
 (8) how well bottom plugged  
2" sand stake

90' 1" P.V.C drop pipe

DRILLERS REMARKS:  
2" sand stake


Miss. Board of Water Comm

SEP 10 1979

RECEIVED

If well telescopes please sketch and show depths.

GROUND LEVEL

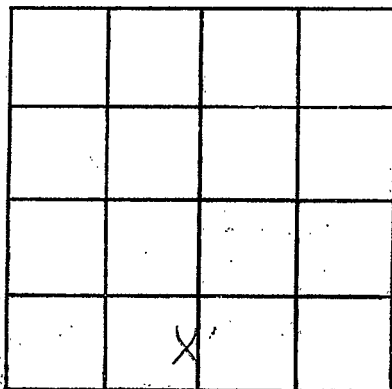

SECTION 15

Please indicate well location X.

ADDITIONAL INFORMATION

If more than one screen, show locations of each on sketch.