

WAYNE

Z 2072

2-27-79

MISSISSIPPI BOARD OF WATER COMMISSIONERS 416 North State Street Jackson, Mississippi 39201

WATER WELL DRILLERS LOG

Feb 27 1979 date well completed Porter Drilling & Pipe Wayne firm name county well located

LANDOWNER: Jimmy & Catherine

Pl 2 Box 40

State Line Miss (mailing address)

WELL LOCATION:

sec 15 T 60 N R 5 E S W 4 miles SE of Buckatunna (distance) (direction) (nearest town)

WELL PURPOSE: Home (home, irrigation, municipal, industrial)

WELL COMPLETION DATA:

- (1) diameter (inches) 2"
(2) total depth (feet) 99'
(3) static water level (feet) 60' below top of ground
(4) casing PVC 94' (material) (depth) 2" (size) if telescope see back.
(5) screen 5' 94' (length) (depth to top) 2" 60lb S.S. (size) (material)
(6) pump 1 10 (HP) (yield gpm) elec (type power)
(7) electric log no (yes or no)
(organization running log)

(8) how well bottom plugged 2" back wash valve

DRILLERS REMARKS:

Table with 3 columns: description of formations encountered, from, to. Rows include clay, fine sand & clay, Clay, fine sand & clay, Clay, wet dense blue sand, and gravel on clay.


Miss. Board of Water Comm.

MAR 19 1979

RECEIVED

If well telescopes please sketch and show depths.

GROUND LEVEL

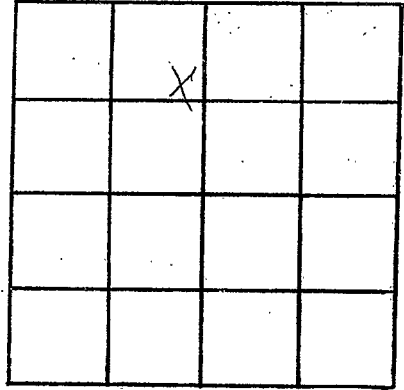

SECTION 15

Please indicate well location X.

ADDITIONAL INFORMATION

If more than one screen,  
show locations of each on sketch.