

WAYNE

Z 2033

04-02-79

MISSISSIPPI BOARD OF WATER COMMISSIONERS 416 North State Street Jackson, Mississippi 39201

WATER WELL DRILLERS LOG McILWAIN WATER WELL SERVICE

April 2

date well completed

19

79

RT. 2 BOX 37

WAYNESBORO, MISS. 39367

Wayne

county well located

LANDOWNER:

Clyde REVETTE Waynesboro Miss. (mailing address)

description of formations encountered

from

to

Red Sandy Clay	0	4
Clay	4	15
SAND	15	20
Clay	20	60
FINE SAND	60	75
Med SAND	75	85

WELL LOCATION:

sec. 5 T 6 N R 5 3 miles SE of Bkenna (distance) (direction) (nearest town)

WELL PURPOSE: HOME (home, irrigation, municipal, industrial)

WELL COMPLETION DATA:

- (1) diameter (inches) 2"
- (2) total depth (feet) 85'
- (3) static water level (feet) 61 1/2' below top of ground
- (4) casing PVC 80' (material) (depth) 2" (size) if telescope see back.
- (5) screen 5' 80' (length) (depth to top) 2" PVC .008 (size) (material)
- (6) pump 1 10 (HP) (yield gpm) 220 AC (type power)
- (7) electric log NO (yes or no)
- (8) how well bottom plugged

DRILLERS REMARKS:


Miss. Board of Water Comm.

APR 24 1979

RECEIVED

If well telescopes please sketch and show depths.

GROUND LEVEL

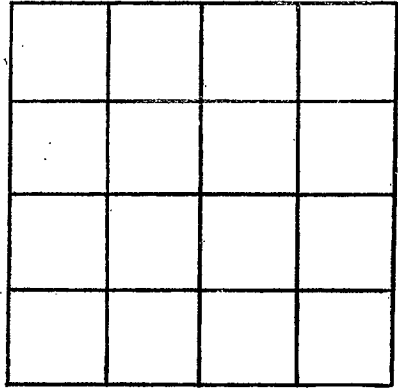

SECTION \_\_\_\_\_

Please indicate well location X.

ADDITIONAL INFORMATION

A series of horizontal lines for recording additional information.

If more than one screen, show locations of each on sketch.