

Wayne  
 2 2024  
 May 8, 1979

MISSISSIPPI  
 BOARD OF WATER COMMISSIONERS  
 416 North State Street  
 Jackson, Mississippi 39201

WATER WELL DRILLERS LOG

MAY 8 1979 date well completed  
 McILWAIN WATER WELL SERVICE WAYNESBORO, MISS. 39367  
 RP. 2, firm name  
 WAYNE county well located

LANDOWNER:	description of formations encountered	from	to
WESLEY DEES	SAND + CLAY	0	12
Buckatunna Miss. (mailing address)	CLAY	12	13
WELL LOCATION: sec. 16 T 6 N R. 5 E S W	SAND + CLAY	13	18
1/2 miles S of Buckatunna (distance) (direction) (nearest town)	CLAY	18	21
WELL PURPOSE: Home (home, irrigation, municipal, industrial)	SAND	31	33
WELL COMPLETION DATA:	Gumbo CLAY	34	41
(1) diameter (inches) 2"	FINE SAND + CLAY	41	48
(2) total depth (feet) 101'	CLAY	48	51
(3) static water level (feet) 23 below top of ground.	Med. SAND + CLAY	51	56
(4) casing PVC 96' (material) (depth) 2" if telescope see back. (size)	CLAY	56	59
(5) screen 5' 96' (length) (depth to top) 2" PVC.008 (size) (material)	FINE SAND	59	60
(6) pump 3/4 10 (HP) (yield gpm)	CLAY	60	74
110 AC (type power)	Med SAND + CLAY	74	79
(7) electric log No (yes or no)	CLAY	79	85
(organization running log)	FINE SAND	85	88
(8) how well bottom plugged	CLAY	88	90
	FINE SAND + CLAY	90	95
	Med. SAND	95	101


DRILLERS REMARKS:

JUN 14 1979

RECEIVED

If well telescopes please sketch and show depths.

GROUND LEVEL

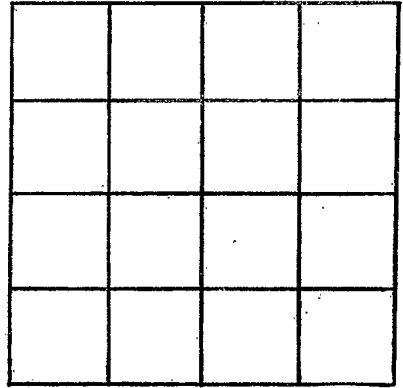

SECTION \_\_\_\_\_

Please indicate well location X.

ADDITIONAL INFORMATION

If more than one screen, show locations of each on sketch.