

Wayne
2
9-28-79

MISSISSIPPI
BOARD OF WATER COMMISSIONERS
416 North State Street
Jackson, Mississippi 39201

8

WATER WELL DRILLERS LOG

9-28-1979 McILWAIN WATER WELL SERVICE Wayne
date well completed P.O. Box 32 county well located

LANDOWNER:
Johnny Lddings
Waynesboro Miss
(mailing address)

WELL LOCATION:
sec. 15 T 6 N R 5 E
3 miles N of State Line
(distance) (direction) (nearest town)

WELL PURPOSE: Home
(home, irrigation, municipal, industrial)

- WELL COMPLETION DATA:
- (1) diameter (inches) 2"
 - (2) total depth (feet) 106'
 - (3) static water level (feet) 66' below top of ground.
 - (4) casing PVC 101' (material) (depth)
2" if telescope see back. (size)
 - (5) screen 5' 101' (length) (depth to top)
2" PVC .008 (size) (material)
 - (6) pump 1 7 (HP) (yield gpm)
220 AC (type power)
 - (7) electric log NO (yes or no)
 - (8) how well bottom plugged

description of formations encountered	from	to
Sand	0	3
Clay + Sand	3	10
White Clay	10	15
Red + White Clay	15	22
Fine Sand + Clay	22	30
Med Sand	30	33
Clay + Sand	33	78
Rock	78	79
Fine Sand	79	98
Med Sand	98	103
Coarse Sand	103	106


DEPT. OF NATURAL RESOURCES
BUREAU OF LAND & WATER RESOURCES

NOV 16 1979
RECEIVED

DRILLERS REMARKS:

If well telescopes please sketch and show depths.

GROUND LEVEL

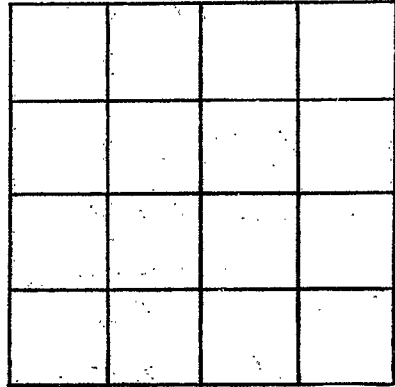

SECTION _____

Please indicate well location X.

ADDITIONAL INFORMATION

If more than one screen, show locations of each on sketch.