

MISSISSIPPI
BOARD OF WATER COMMISSIONERS
416 North State Street
Jackson, Mississippi 39201

WATER WELL DRILLERS LOG

W. 0030
6/17/80

March 20, 1980 date well completed *Auto Drilling & Log* firm name *Wayne* county well located

LANDOWNER: *Shelton Martin*
Waynesboro, Miss.
(mailing address)

description of formations encountered	from	to
<i>clay</i>	<i>0</i>	<i>16</i>
<i>sand</i>	<i>16</i>	<i>23</i>
<i>stagnant on clay</i>		

WELL LOCATION:
sec. *14* T. *6* N. R. *5* E.
4 miles *SW* of *Burbank*
(distance) (direction) (nearest town)

WELL PURPOSE: *Camp*
(home, irrigation, municipal, industrial)

WELL COMPLETION DATA:

- (1) diameter (inches) *2"*
- (2) total depth (feet) *23'*
- (3) static water level (feet) *3'* below above
top of ground.
- (4) casing *PVC 23'*
(material) (depth)
2"
(size) if telescope see back.
- (5) screen *5'* *23'*
(length) (depth to top)
2" *solid PVC*
(size) (material)
- (6) pump *1/2* *12*
(HP) (yield gpm)
elec.
(type power)
- (7) electric log *no*
(yes or no)

(organization running log)

(8) how well bottom plugged *2" PVC sand shale*

DRILLERS REMARKS:


DEPT. OF NATURAL RESOURCES
BUREAU OF LAND & WATER RESOURCES

JUN 20 1980

RECEIVED

If well telescopes please sketch and show depths.

GROUND LEVEL

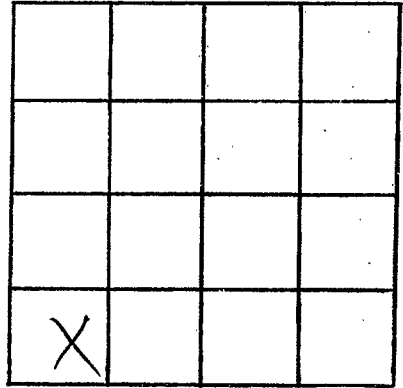

SECTION 14

Please indicate well location X.

ADDITIONAL INFORMATION

If more than one screen,
show locations of each on sketch.