

MISSISSIPPI DEPARTMENT OF NATURAL RESOURCES

Bureau of Land and Water Resources

Southport Mall

P.O. Box 10631

Jackson, Mississippi 39209

WATER WELL DRILLERS LOG

6

WAYNE
Z 2057
1/19/81

Jan 19 1981 Roots-Drilling, Inc. Itzume
date well completed firm name county well located

LANDOWNER: Walter Gray Hall
P.O. Box 304
Plate Line Miss
(mailing address)

description of formations encountered	from	to
sand to clay	0	50
med white sand	50	60
stony white shell		
sh. sand		

WELL LOCATION:
sec. 9 T. 6 N. R. 5 E.
3 miles S of Buckatunna
(distance) (direction) (nearest town)

40" V.P.C. drainage pipe

WELL PURPOSE: home
(home, irrigation, municipal, industrial)

WELL COMPLETION DATA:

(1) diameter (inches) 2'

(2) total depth (feet) 60

(3) static water level (feet) 33 below top of ground.

(4) casing P.V.C. 55'
(material) (depth)
2" (size) if telescope see back.

(5) screen 5' 55'
(length) (depth to top)
2" 8 slot SS.
(size) (material)

(6) pump 3/4 8
(HP) (yield gpm)
elec.
(type power)

(7) electric log no
(yes or no)
(organization running log)

(8) how well bottom plugged
2" back wash valve

DRILLERS REMARKS:


DEPT. OF NATURAL RESOURCES
BUREAU OF LAND & WATER RESOURCES

JAN 23 1981

RECEIVED

If well telescopes please sketch and show depths.

GROUND LEVEL

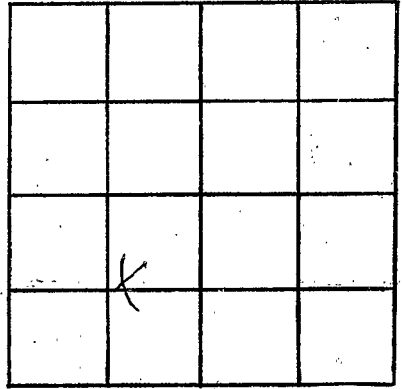

SECTION 9

Please indicate well location X.

ADDITIONAL INFORMATION

If more than one screen,
show locations of each on sketch.