

**MISSISSIPPI DEPARTMENT OF NATURAL RESOURCES**  
**Bureau of Land and Water Resources**  
 Southport Mall  
 P.O. Box 10631  
 Jackson, Mississippi 39209  
**WATER WELL DRILLERS LOG**

WAYNE  
22000

7/28 1996 CARR'S WELL SER. WAYNE  
 date well completed firm name county well located

LANDOWNER: L.R. TAYLOR  
BTI

STATE LINE, MS.  
 (mailing address)

WELL LOCATION:  
 sec. 21 T. 6N S. R. 5E W. 1 miles W of ERET  
 (distance) (direction) (nearest town)

WELL PURPOSE: HOME  
 (home, irrigation, municipal, industrial)

WELL COMPLETION DATA:

(1) diameter (inches) 2"

(2) total depth (feet) 76

(3) static water level (feet) 35 below above top of ground.

(4) casing P.V.C. 71'  
 (material) (depth)

       if telescope see back.  
 (size)

(5) screen 5' 71'  
 (length) (depth to top)

2" P.V.C.  
 (size) (material)

(6) pump 1 12  
 (HP) (yield gpm)

ELEC  
 (type power)


(7) electric log         
 (yes or no)

        
 (organization running log)

| description of formations encountered | from      | to        |
|---------------------------------------|-----------|-----------|
| <u>SANDY CLAY</u>                     | <u>0</u>  | <u>13</u> |
| <u>CLAY</u>                           | <u>13</u> | <u>22</u> |
| <u>SD</u>                             | <u>22</u> | <u>24</u> |
| <u>CLAY</u>                           | <u>24</u> | <u>42</u> |
| <u>SD</u>                             | <u>42</u> | <u>45</u> |
| <u>CLAY</u>                           | <u>45</u> | <u>68</u> |
| <u>SD, MED. COURSE</u>                | <u>68</u> | <u>75</u> |
| <u>STOPPED IN SD.</u>                 |           |           |

(8) how well bottom plugged SD TRAP  
4 B.W. PLUG WITH 1/2" B.P.


DRILLERS REMARKS:       

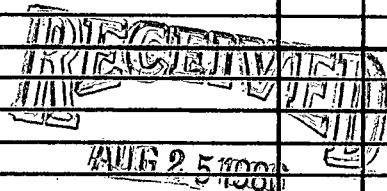

Mississippi Department of Natural Resources  
Bureau of Land and Water Resources

If well telescopes please sketch and show depths.

GROUND LEVEL

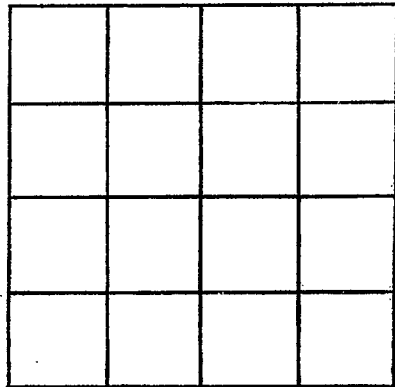

SECTION \_\_\_\_\_

Please indicate well location X.

ADDITIONAL INFORMATION

If more than one screen,  
show locations of each on sketch.