

MISSISSIPPI DEPARTMENT OF NATURAL RESOURCES

Bureau of Land and Water Resources

Southport Mall

P.O. Box 10631

Jackson, Mississippi 39209

WATER WELL DRILLERS LOG

WAYNE
Z

8-19 1986 CARR'S WELL SER. WAYNE
date well completed firm name county well located

LANDOWNER: CYD E BEUTTE
PT. 1 BUCKATUNNA,
MS. 39322
(mailing address)

WELL LOCATION:
sec. 5 T. 6 N. R. 5 E.
3 miles S of BUCK
(distance) (direction) (nearest town)

WELL PURPOSE: HOME
(home, irrigation, municipal, industrial)

WELL COMPLETION DATA:

- (1) diameter (inches) 4"
- (2) total depth (feet) 169
- (3) static water level (feet) 24 ^{below} _{above} top of ground.
- (4) casing PVC, 154'
(material) (depth)
- (5) screen 15', 154'
(length) (depth to top)
2", PVC
(size) (material)
- (6) pump 1 sub 43
(HP) (yield gpm)
Elect
(type power)
- (7) electric log no
(yes or no)
- (8) how well bottom plugged 2" BWV.
2 1/2" left thru

description of formations encountered	from	to
Top Soil	0	1
CLAY	1	10
SAND	10	11
CLAY	11	39
FINE SAND	39	56
SAND w/ some CLAY	56	60
COARSE SAND	60	70
CLAY	70	73
SAND	73	95
SAND Reduced Nake	95	100
CLAY	100	101
SAND	101	105
CLAY	105	108
SAND	108	110
CLAY	110	117
SAND	117	120
CLAY	120	131
FINE SAND	131	150
COARSE SAND	150	169


RECEIVED
OCT 20 1986

Department of Natural Resources
Bureau of Land & Water Resources

DRILLERS REMARKS: well
PUMPING OPEN END
To 130yd
PUMP @ 80'

52
If well telescopes please sketch and show depths.

GROUND LEVEL

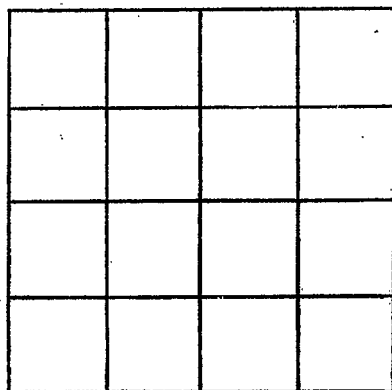

SECTION _____

Please indicate well location X.

ADDITIONAL INFORMATION

If more than one screen,
show locations of each on sketch.