

CODED

CODED

CODED

MISSISSIPPI  
 BOARD OF WATER COMMISSIONERS  
 416 North State Street  
 Jackson, Mississippi 39201

WATER WELL DRILLERS LOG

Webster  
A3  
9-2-68

9-2 1968 Charles Lovorn Webster  
 date well completed firm name county well located

LANDOWNER: W.D. + Wmna

description of formations encountered	from	to
<u>Dixon</u>		
<u>Red clay</u>	<u>0</u>	<u>10</u>
<u>Blue sandstone</u>	<u>10</u>	<u>200</u>
<u>Blue sand</u>	<u>200</u>	<u>240</u>

Dixon  
Deed Hill Miss.  
 (mailing address)

WELL LOCATION:  
 sec 8 T 21 N R 8 E  
3 miles S. West of Cadaretta  
 (distance) (direction) (nearest town)

WELL PURPOSE: home  
 (home, irrigation, municipal, industrial)

WELL COMPLETION DATA:

- (1) diameter (inches) 4
- (2) total depth (feet) 240
- (3) static water level (feet) 50 <sup>below</sup>/<sub>above</sub> top of ground.
- (4) casing Plastic, 160'  
 (material) (depth)  
 \_\_\_\_\_ if telescope see back.  
 (size)
- (5) screen \_\_\_\_\_  
 (length) (depth to top)  
 \_\_\_\_\_  
 (size) (material)
- (6) pump 3/4 8  
 (HP) (yield gpm)  
Electric  
 (type power)
- (7) electric log no  
 (yes or no)  
 \_\_\_\_\_  
 (organization running log)
- (8) how well bottom plugged Open

CODED


DRILLERS REMARKS:

FEB 21 1969

MISS. BD. OF WATER COMM.

If well telescopes please sketch and show depths.

GROUND LEVEL

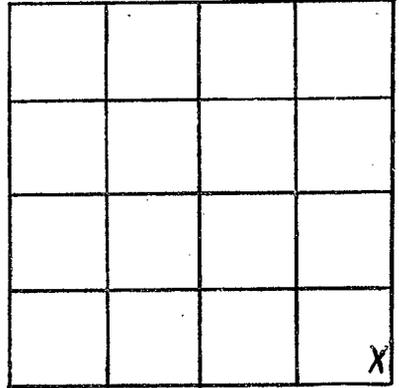

SECTION 8

Please indicate well location X.

ADDITIONAL INFORMATION

If more than one screen, show locations of each on sketch.