

CODED

CODED

CODED

Webster  
A4  
10-1-68

MISSISSIPPI  
BOARD OF WATER COMMISSIONERS  
416 North State Street  
Jackson, Mississippi 39201

WATER WELL DRILLERS LOG

~~10-1~~ 19 68 Charles Loren Webster  
date well completed firm name county well located

LANDOWNER:

Rufus Martin  
Bellefontaine Miss  
(mailing address)

description of formations encountered

from to

Red Clay 0 10  
Blue sandstone 10 200  
Blue gray sand 200 240

WELL LOCATION:

sec. 17 T. 21 R. 8 E  
S. 5 W. W  
3 1/4 miles west of Calcutta  
(distance) (direction) (nearest town)

WELL PURPOSE:

Home  
(home, irrigation, municipal, industrial)

WELL COMPLETION DATA:

- (1) diameter (inches) 4
- (2) total depth (feet) 240
- (3) static water level (feet) 50 below top of ground.
- (4) casing Plastic, 160,  
(material) (depth)  
3/4 if telescope see back.  
(size)
- (5) screen \_\_\_\_\_  
(length) (depth to top)  
(size) (material)
- (6) pump 3/4 3  
(HP) (yield gpm)  
Electric  
(type power)
- (7) electric log NO  
(yes or no)  
(organization running log)
- (8) how well bottom plugged Open

CODED


DRILLERS REMARKS:

FEB 21 1969

MISS. BD. OF  
WATER COM.

If well telescopes please sketch and show depths.

GROUND LEVEL

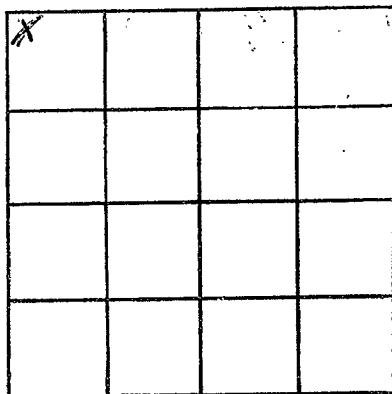

SECTION 17

Please indicate well location X.

ADDITIONAL INFORMATION

If more than one screen, show locations of each on sketch.