

CODED

MISSISSIPPI
BOARD OF WATER COMMISSIONERS
416 North State Street
Jackson, Mississippi 39201

CODED

WATER WELL DRILLERS LOG

Webster
A5
10-5-68

10-5 1968 Chacee Lowery Webster
date well completed firm name county well located

LANDOWNER: J.H. Pittman

Description of formations encountered from to

Yore Springs
Miss.
(mailing address)

Clay
White Sand 0 15
15 120

WELL LOCATION:

sec. 5 T21 N R 8 E
2 miles N. west of Cabaretta
(distance) (direction) (nearest town)

WELL PURPOSE: home
(home, irrigation, municipal, industrial)

WELL COMPLETION DATA:

- (1) diameter (inches) 4
- (2) total depth (feet) 120'
- (3) static water level (feet) 30' below top of ground.
- (4) casing plastic, 120' (material) (depth)
- (size) if telescope see back.
- (5) screen (length) (depth to top)
- (size) (material)
- (6) pump 3/4 (HP) 6 (yield gpm)
- Electric (type power)
- (7) electric log no. (yes or no)
- (organization running log)
- (8) how well bottom plugged grouted

CODED


FEB 21 1969

DRILLERS REMARKS:

MISS. BD. OF
WATER COMMISSIONERS

If well telescopes please sketch and show depths.

GROUND LEVEL

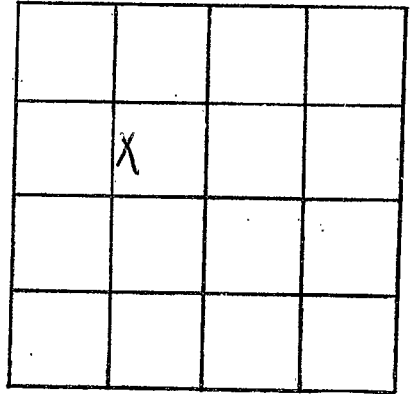

SECTION 5

Please indicate well location X.

ADDITIONAL INFORMATION

If more than one screen,
show locations of each on sketch.