

WEBSTER

A 7

7-67

156

MISSISSIPPI
 BOARD OF WATER COMMISSIONERS
 416 North State Street
 Jackson, Mississippi 39201

CODED

CODED

WATER WELL DRILLERS LOG

7-18
date well completed

1967 Charles Lovorn Webster
firm name

county well located

LANDOWNER: C.D. Christopher

Description of formations encountered

from to

Grenada
Miss, 38901
(mailing address)

Clay & Shale	0	15
shales & sand	15	51
Shale	51	66

WELL LOCATION:

sec. 3 T. 21 N. R. 8 E. S. 5 W.
 (distance) miles (direction) of Cedarville
 (nearest town)

WELL PURPOSE:
(home, irrigation, municipal, industrial)

WELL COMPLETION DATA:

- (1) diameter (inches) 4"
- (2) total depth (feet) 66'
- (3) static water level (feet) below top of ground.
- (4) casing plastic, 66' (material) (depth)
 (size) If telescope see back.
- (5) screen (length) (depth to top)
 (size) (material)
- (6) pump 1/2 (HP) 4 Per Min (yield gpm)
 Electric (type power)
- (7) electric log no (yes or no)
 (organization running log)
- (8) how well bottom plugged gravel

CODED


JUN 17 1967

MISS. DEPT. OF WATER CONTROL

DRILLERS REMARKS:

If well telescopes please sketch and show depths.

GROUND LEVEL

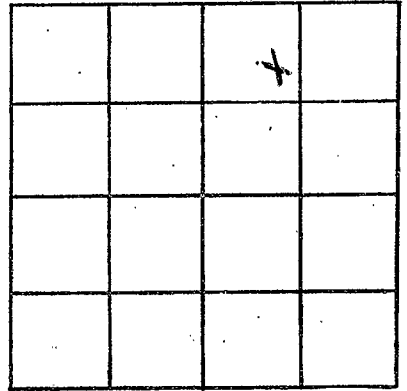

SECTION 302

Please indicate well location X.

ADDITIONAL INFORMATION

If more than one screen,
show locations of each on sketch.