

CODED
FIELD

MISSISSIPPI
BOARD OF WATER COMMISSIONERS
416 North State Street
Jackson, Mississippi 39201

WATER WELL DRILLERS LOG

Webster
A8
7-67

7-26 1967 Charles Lorenz Mehetus
date well completed firm name county well located

LANDOWNER: R. O'Neal

description of formations encountered	from	to
Red clay	0	15
Blue shell	15	100
White sand	100	176

Rt -
Eupora Miss, 39749
(mailing address)

WELL LOCATION:
sec. 17 T 21 N R 8 E
S W
2 miles SW of Cedarville
(distance) (direction) (nearest town)

WELL PURPOSE: Home
(home, irrigation, municipal, industrial)

WELL COMPLETION DATA:
(1) diameter (inches) 4"
(2) total depth (feet) 176'
(3) static water level (feet) 40' (below top of ground)
(4) casing Plastic, 166'
(material) (depth)

_____ if telescope see back.
(size)
(5) screen _____
(length) (depth to top)
(size) (material)

(6) pump 1 6 Per gal
(HP) (yield gpm)
Electric
(type power)

(7) electric log no
(yes or no)
(organization running log)

(8) how well bottom plugged Open
~~plugged~~


DRILLERS REMARKS:

CODED

JUL 12 1968
MISS. BOARD OF
WATER COMM.

If well telescopes please sketch and show depths.

GROUND LEVEL

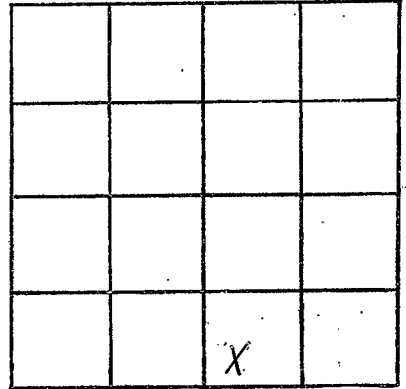

SECTION 17

Please indicate well location X.

ADDITIONAL INFORMATION

If more than one screen,
show locations of each on sketch.