

CODED

CODED

Webster
A9
8-67

MISSISSIPPI
BOARD OF WATER COMMISSIONERS
416 North State Street
Jackson, Mississippi 39201

WATER WELL DRILLERS LOG

8-31 1967 date well completed
Charles Lovern firm name
Webster county well located

LANDOWNER: Mrs Pearl Neal
Duck Hill
Miss.
(mailing address)

description of formations encountered	from	to
Red Clay	0	15
Blue Shale	15	23.5
	23.5	

WELL LOCATION:
sec 29 T 21 N R 8 E S
1 1/2 miles E. of Alma
(distance) (direction) (nearest town)

Blue Shale	15	23.5
Blue Sand	23.5	280

WELL PURPOSE:
(home, irrigation, municipal, industrial)

WELL COMPLETION DATA:

- (1) diameter (inches) 4"
- (2) total depth (feet) 280
- (3) static water level (feet) 80' below top of ground.
- (4) casing Plastic, 160, (material) (depth)
- (size) If telescope see back.
- (5) screen (length) (depth to top)
- (size) (material)
- (6) pump 1 (HP) 6 (yield gpm)
- Electric (type power)
- (7) electric log NO (yes or no)
- (organization running log)
- (8) how well bottom plugged open


CODED

JUL 18 1968
MISS. BOARD OF
WATER COM. STAMP

DRILLERS REMARKS:

If well telescopes please sketch and show depths.

GROUND LEVEL

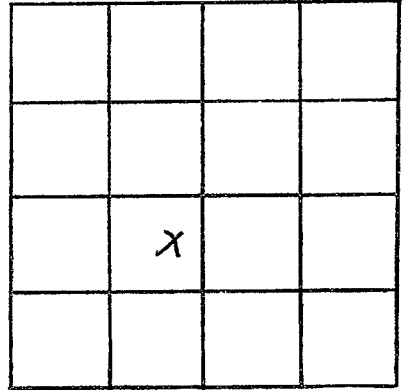

SECTION 29

Please indicate well location X.

ADDITIONAL INFORMATION

If more than one screen, show locations of each on sketch.