

Webster  
A 11  
6-28-69

MISSISSIPPI  
 BOARD OF WATER COMMISSIONERS CODED  
 416 North State Street  
 Jackson, Mississippi 39201

WATER WELL DRILLERS LOG

6-28 1969 Charles Lorton Webster  
 date well completed firm name county well located

LANDOWNER:  
Jackie & Bill Gray  
Yare Springs Miss  
 (mailing address)

description of formations encountered	from	to
<u>White Clay</u>	<u>0</u>	<u>45</u>
<u>Sand Gray</u>	<u>45</u>	<u>150</u>

WELL LOCATION:  
 sec. 23 T. 21 N. R. 8 E  
18 miles N.W. of Europa  
 (distance) (direction) (nearest town)

WELL PURPOSE: None  
 (home, irrigation, municipal, industrial)

- WELL COMPLETION DATA:
- diameter (inches) 4"
  - total depth (feet) 150'
  - static water level (feet) 40' <sup>(below)</sup> above top of ground.
  - casing Plastic 150'  
 (material) (depth)  
 (size) if telescope see back.
  - screen \_\_\_\_\_  
 (length) (depth to top)  
 (size) (material)
  - pump 1 1/2 1.2  
 (HP) (yield gpm)  
Electric  
 (type power)
  - electric log no  
 (yes or no)  
 (organization running log)
  - how well bottom plugged Gravel


DRILLERS REMARKS:

OCT 6 - 1969

MISS. BD. OF  
 WATER COMMISSIONERS

If well telescopes please sketch and show depths.

GROUND LEVEL

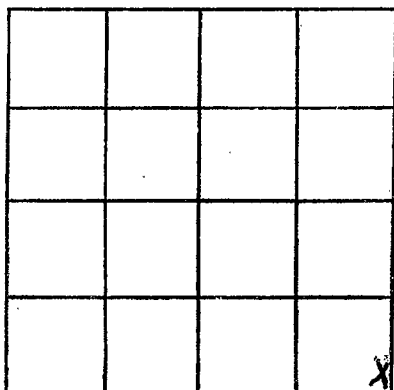

SECTION 23NE

Please indicate well location X.

ADDITIONAL INFORMATION

If more than one screen,  
show locations of each on sketch.