

WEBSTER  
A 13  
1-20

MISSISSIPPI  
BOARD OF WATER COMMISSIONERS

**CODED**

10 North State Street  
Jackson, Mississippi 39201

uses

Elog # 25

WATER WELL DRILLERS LOG

1-20  
date well completed

1970 Charles Lovorn  
firm name

Webster  
county well located

LANDOWNER: Beel Middleton  
RT 1  
Spring Hill  
(mailing address)

description of formations encountered	from	to
	Red Clay	0
blue shell	20	20
blue sand	120	176

WELL LOCATION:  
sec. 21 T. 21 N. R. 8 E. S. 5 W.  
4 1/2 miles West of Spring Hill  
(distance) (direction) (nearest town)

**CODED**

WELL PURPOSE: Home  
(home, irrigation, municipal, industrial)

NOV 8 - 1970  
MISS. BD OF WATER COM.

WELL COMPLETION DATA:  
(1) diameter (inches) 4"  
(2) total depth (feet) 176'  
(3) static water level (feet) \_\_\_\_\_ below/above top of ground.  
(4) casing Plastic, 120' (material) (depth)  
(size) If telescope see back.  
(5) screen \_\_\_\_\_ (length) \_\_\_\_\_ (depth to top)  
(size) (material)  
(6) pump 3/4 (HP) \_\_\_\_\_ (yield gpm)  
Electric (type power)  
(7) electric log No, MGS (yes or no)  
(organization running log)  
(8) how well bottom plugged Open

**CODED**

This well was not completed as Mr. Middleton did not expect it. So he got someone else to finish.

This is the reason I didn't send it in as we did not complete it.


**CODED**

DRILLERS REMARKS:

Mr. Lovorn

If well telescopes please sketch and show depths.

GROUND LEVEL

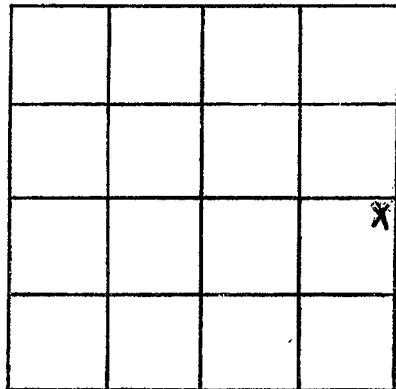

SECTION 21

Please indicate well location X.

ADDITIONAL INFORMATION

*Richard  
Scoring*

If more than one screen,  
show locations of each on sketch.