

Webster
B3
5-68

CODER

MISSISSIPPI
BOARD OF WATER COMMISSIONERS
416 North State Street
Jackson, Mississippi 39201

WATER WELL DRILLERS LOG

5-14 1968 Charles Brown Webster
date well completed firm name county well located

LANDOWNER:
Bobby Waits
Eupora Miss.
(mailing address)

description of formations encountered	from	to
	Clay	0
blue shale	10	90
gray sand	90	132

WELL LOCATION:
sec 28 T. 21 N. R. 9 E
3 miles NW of Bellefontaine
(distance) (direction) (nearest town)

WELL PURPOSE: home
(home, irrigation, municipal, industrial)

WELL COMPLETION DATA:

(1) diameter (inches) 4"

(2) total depth (feet) 132'

(3) static water level (feet) 40' below top of ground.

(4) casing Plastic, 132' (material) (depth)

_____ if telescope see back. (size)

(5) screen _____ (length) _____ (depth to top)

_____ (size) _____ (material)

(6) pump 1 (HP) 4 (yield gpm)

Electric (type power)

(7) electric log no (yes or no)

_____ (organization running log)

(8) how well bottom plugged Gravelled


CODER

APR 28 1968
MISS. BOARD OF
WATER COMM.

DRILLERS REMARKS:

If well telescopes please sketch and show depths.

GROUND LEVEL

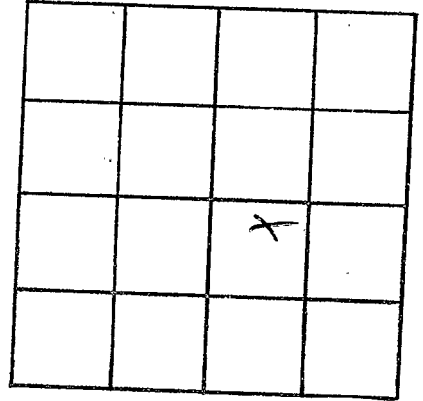

SECTION 28

Please indicate well location X.

ADDITIONAL INFORMATION

If more than one screen, show locations of each on sketch.