

CODED CODED

Webster
B 4
10-26-69

MISSISSIPPI
BOARD OF WATER COMMISSIONERS
416 North State Street
Jackson, Mississippi 39201

WATER WELL DRILLERS LOG

10-26-1969 date well completed
Charles Lovorn firm name
Webster county well located

LANDOWNER:
James G. Bennett Jr.
Eupora Miss R13
(mailing address)
WELL LOCATION:
sec. 21 T. 21 N. R. 9 E
6 miles S of Bellefontaine Miss
(distance) (direction) (nearest town)

description of formations encountered	from	to
Red Clay	0	20
Sand Stone	20	180
Grav Sand	180	240

WELL PURPOSE: home
(home, irrigation, municipal, industrial)

WELL COMPLETION DATA:

- (1) diameter (inches) 4"
- (2) total depth (feet) 240'
- (3) static water level (feet) 40' below above top of ground.
- (4) casing Plastic 160' (material) (depth)
- (size) if telescope see back.
- (5) screen (length) (depth to top)
- (size) (material)
- (6) pump 3/4 (HP) (yield gpm)
- Electric (type power)
- (7) electric log No. (yes or no)

(organization running log)

(8) how well bottom plugged Open


JAN 14 1970

MISS. BD. OF
WATER COMMISSIONERS

DRILLERS REMARKS:

If well telescopes please sketch and show depths.

GROUND LEVEL

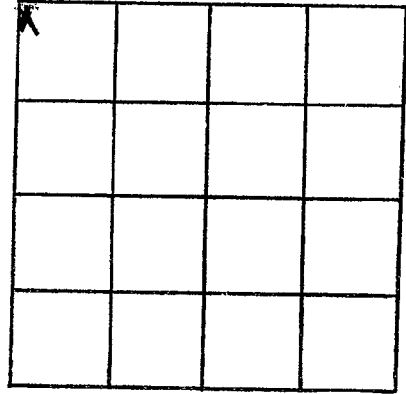

SECTION 21

Please indicate well location X.

ADDITIONAL INFORMATION

Lined area for additional information.

If more than one screen, show locations of each on sketch.