

CODED

MISSISSIPPI BOARD OF WATER COMMISSIONERS
416 North State Street
Jackson, Mississippi 39201

WATER WELL DRILLERS LOG

Webster
B5
7-26-72

July 26 1972 Charles Korum Mekester
date well completed firm name county well located

LANDOWNER: Mt. Vernon
Church, Rt 1,
Esopra, Miss
(mailing address)

description of formations encountered	from	to
Red Sand	0	66
yellow Sand	66	110

WELL LOCATION:
sec 29 T. 9 N. R. 9 E.
7 21 S W
(distance) miles (direction) of Esopra, Miss (nearest town)

WELL PURPOSE: Church
(home, irrigation, municipal, industrial)

- WELL COMPLETION DATA:
- (1) diameter (inches) 4"
 - (2) total depth (feet) 110'
 - (3) static water level (feet) 80' below top of ground.
 - (4) casing Plastic 110' (material) (depth)
(size) if telescope see back.
 - (5) screen (length) (depth to top)
(size) (material)
 - (6) pump 3/4 (HP) 5 (yield gpm)
Electric (type power)
 - (7) electric log No. (yes or no)
(organization running log)
 - (8) how well bottom plugged Gravel


CODED

NOV 18 1972

DRILLERS REMARKS:

If well telescopes please sketch and show depths.

GROUND LEVEL

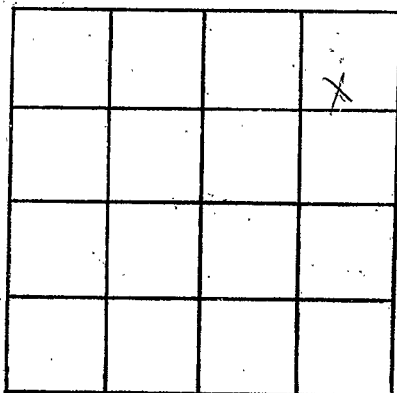

SECTION 21

Please indicate well location X.

ADDITIONAL INFORMATION

If more than one screen,
show locations of each on sketch.