

Webster

B 2000

10-21-75

MISSISSIPPI  
 BOARD OF WATER COMMISSIONERS  
 416 North State Street  
 Jackson, Mississippi 39201

WATER WELL DRILLERS LOG

Oct 21

date well completed

1975 Charles Loren

firm name

Webster

county well located


LANDOWNER: <u>Howard Shelton</u>	description of formations encountered	from	to
<u>Rt 3</u>			
<u>Colham City, Ms.</u> (mailing address)	<u>Red clay</u>	<u>0</u>	<u>20</u>
	<u>Blue + Black shell</u>	<u>20</u>	<u>60</u>
	<u>Blue shell with</u>	<u>100</u>	<u>120</u>
	<u>white traces</u>		
	<u>Blue + white + gray sand</u>	<u>120</u>	<u>200</u>
WELL LOCATION: sec. <u>5</u> T <u>21</u> N R. <u>9</u> E 156 <u>2</u> miles <u>S</u> of <u>Webster</u> (distance) (direction) (nearest town)			
WELL PURPOSE: <u>Home</u> (home, irrigation, municipal, industrial)			
WELL COMPLETION DATA:			
(1) diameter (inches) <u>4"</u>			
(2) total depth (feet) <u>200'</u>			
(3) static water level (feet) <u>42'</u> <u>below</u> above top of ground.			
(4) casing <u>plastic</u> <u>120'</u> (material) (depth)			
(size) If telescope see back.			
(5) screen <u>80'</u> <u>120'</u> (length) (depth to top)			
<u>2'</u> <u>gravel packed</u> (size) (material)			
(6) pump <u>1</u> <u>10</u> (HP) (yield gpm)			
<u>electric</u> (type power)			
(7) electric log <u>                    </u> (yes or no)			
<u>  </u> (organization running log)			
(8) how well bottom plugged <u>Gravel</u>			
DRILLERS REMARKS: <u>  </u>			

RECEIVED  
 OCT 20 1975

MISS. BD. OF WATER COMM.

If well telescopes please sketch and show depths.

GROUND LEVEL

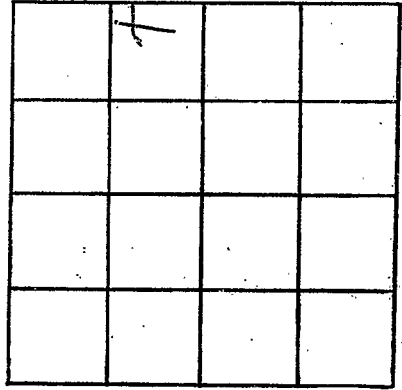

SECTION \_\_\_\_\_

Please indicate well location X.

ADDITIONAL INFORMATION

If more than one screen, show locations of each on sketch.