

WEBSTER
C10
7-10-70

MISSISSIPPI
 BOARD OF WATER COMMISSIONERS
 416 North State Street
 Jackson, Mississippi 39201

CODED

WATER WELL DRILLERS LOG

7-10 1970 Charles Lovorn Webster
 date well completed firm name county well located

LANDOWNER:	description of formations encountered	from	to
(mailing address)			
<u>Lanny Day</u>	<u>Red clay</u>	<u>0</u>	<u>40</u>
<u>Esperanza Miss Rt 2</u>	<u>Blue shale</u>	<u>40</u>	<u>90</u>
	<u>Blue + white sand</u>	<u>90</u>	<u>110</u>

WELL LOCATION:
 sec 27 22 T 21 S R 10 W
3 miles NE of Webbville
 (distance) (direction) (nearest town)

WELL PURPOSE: Home
 (home, irrigation, municipal, industrial)

- WELL COMPLETION DATA:
- (1) diameter (inches) 4"
 - (2) total depth (feet) 110'
 - (3) static water level (feet) 60' ^{below} _{above} top of ground.
 - (4) casing Plastic, 110'
 (material) (depth)
 (size) if telescope see back.
 - (5) screen _____ (length) _____ (depth to top)
 (size) _____ (material)
 - (6) pump 3/4 6
 (HP) (yield gpm)
Electric
 (type power)
 - (7) electric log No.
 (yes or no)
 (organization running log)
 - (8) how well bottom plugged Gravel

CODED


NOV 6 - 1970

MISS. DIV. OF
 WATER CONTROL

DRILLERS REMARKS:

If well telescopes please sketch and show depths.

GROUND LEVEL

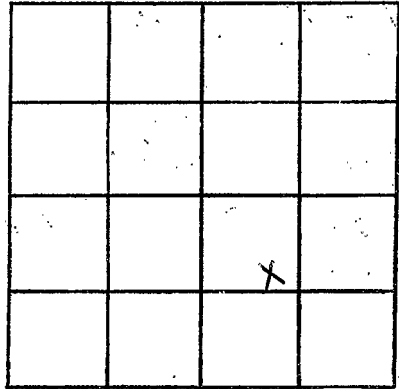

SECTION 22

Please indicate well location X.

ADDITIONAL INFORMATION

If more than one screen, show locations of each on sketch.