

WEBSTER
C 2
8-19-70

MISSISSIPPI
 BOARD OF WATER COMMISSIONERS
 416 North State Street
 Jackson, Mississippi 39201

CODED

WATER WELL DRILLERS LOG

8-19 1970 Charles Loxon Webster
 date well completed firm name county well located

LANDOWNER:
H. B. Sewell
Esperanza, Miss.
 (mailing address)

description of formations encountered	from to	
	feet	feet
<u>Red Clay</u>	<u>0</u>	<u>20</u>
<u>Red Sand</u>	<u>20</u>	<u>80</u>
<u>Blue Sand</u>	<u>80</u>	<u>120</u>

WELL LOCATION:
 sec. 26 T 21 N R. 10 E
4 miles NE of Walthall Miss.
 (distance) (direction) (nearest town)

WELL PURPOSE: Home
 (home, irrigation, municipal, industrial)

- WELL COMPLETION DATA:**
- (1) diameter (inches) 4
 - (2) total depth (feet) 120
 - (3) static water level (feet) 6 below top of ground. above
 - (4) casing plastic, 120,
 (material) (depth)
 _____ if telescope see back.
 (size)
 - (5) screen _____ (length) _____ (depth to top)
 (size) _____ (material)
 - (6) pump 1/2 _____ 5
 (HP) (yield gpm)
Electric
 (type power)
 - (7) electric log NO
 (yes or no)
 - _____ (organization running log)
 - (8) how well bottom plugged gravel

CODED


NOV 6 - 1970

MISS. BD. OF
 WATER COMM.

DRILLERS REMARKS:

If well telescopes please sketch and show depths.

GROUND LEVEL

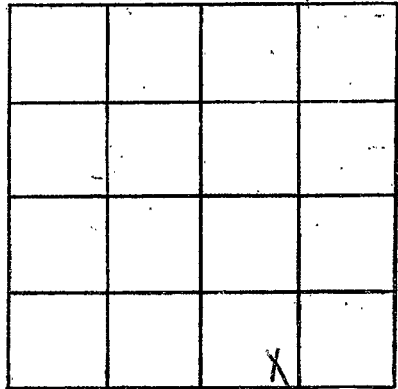

SECTION 24

Please indicate well location X.

ADDITIONAL INFORMATION

A series of horizontal lines for recording additional information.

If more than one screen, show locations of each on sketch.