

Webster  
C5  
10-15-71

MISSISSIPPI  
 BOARD OF WATER COMMISSIONERS  
 416 North State Street  
 Jackson, Mississippi 39201

**CODED**

WATER WELL DRILLERS LOG

Oct 15 19 71 Charles Town Webster  
 date well completed firm name county well located

LANDOWNER: James Whitaker  
RT. 2  
Eupora, Miss  
 (mailing address)

description of formations encountered

	from	to
<u>Red, Blue, Gray clay</u>	<u>0</u>	<u>100</u>
<u>B. blue &amp; Gray Sand</u>	<u>100</u>	<u>154</u>

WELL LOCATION:  
 sec. 24 T. 21 N. R. 10 E.  
 S W  
10 miles NE of Eupora  
 (distance) (direction) (nearest town)

WELL PURPOSE: Home  
 (home irrigation, municipal, industrial)


- WELL COMPLETION DATA:
- (1) diameter (inches) 4"
  - (2) total depth (feet) 154
  - (3) static water level (feet) 40 below above top of ground.
  - (4) casing Pl, 100'  
 (material) (depth)
  - 0 if telescope see back.  
 (size)
  - (5) screen 54  
 (length) (depth to top)
  - 2, Plc  
 (size) (material)
  - (6) pump 3/4, 10  
 (HP) (yield gpm)
  - Elec  
 (type power)
  - (7) electric log No  
 (yes or no)
  - (organization running log)
  - (8) how well bottom plugged screened  
capped

**CODED**

DRILLERS REMARKS:

If well telescopes please sketch and show depths.

GROUND LEVEL

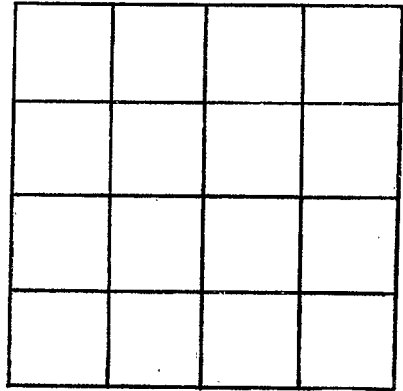

SECTION \_\_\_\_\_

Please indicate well location X.

ADDITIONAL INFORMATION

If more than one screen, show locations of each on sketch.