

Webster
C-6

MISSISSIPPI
BOARD OF WATER COMMISSIONERS
416 North State Street
Jackson, Mississippi 39201

CODED

WATER WELL DRILLERS LOG

Aug 4 - 1980 Charles Brown Webster
date well completed firm name county well located

LANDOWNER: John Martinez
Rt 4
Eupora Miss 39744
(mailing address)

description of formations encountered	from	to
Red clay	0	22
Shell + sand Blue tip	22	44
Blue shell also sand	44	200
Blue Shell	200	300

WELL LOCATION:
sec. 1 T 21(N) R 10(E)
12 miles NE of Eupora
(distance) (direction) (nearest town)

WELL PURPOSE: Home
(home, irrigation, municipal, industrial)

- WELL COMPLETION DATA:
- (1) diameter (inches) 4"
 - (2) total depth (feet) 300
 - (3) static water level (feet) 40 ~~below~~ above top of ground.
 - (4) casing Plastic, 160
(material) (depth)
(size) if telescope see back.
 - (5) screen _____
(length) (depth to top)
(size) (material)
 - (6) pump 1 5
(HP) (yield gpm)
Electric
(type power)
 - (7) electric log yes
(yes or no)
Mrs. Sgt. Raymond Resources
(organization running log)
 - (8) how well bottom plugged Opened

CODED


DEPT. OF NATURAL RESOURCES
BUREAU OF LAND & WATER RESOURCES

AUG 15 1980
RECEIVED

DRILLERS REMARKS:

If well telescopes please sketch and show depths.

GROUND LEVEL

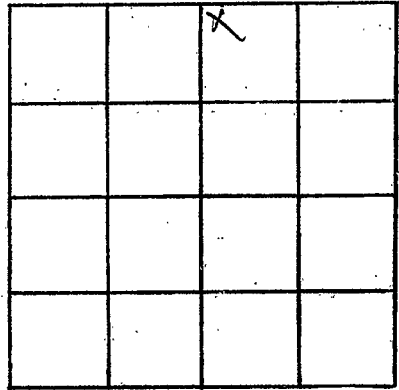

SECTION 1

Please indicate well location X.

ADDITIONAL INFORMATION

If more than one screen, show locations of each on sketch.